

# LABOR AND MATERIALS

<u>1</u>	Copper Lead } Connection	_____	\$ _____
<u>1</u>	Curb } Cock Valve } <del>F.O.C.V.</del>	_____ in.	\$ _____
<u>1</u>	Service box } Short 3-1/2 x 4-1/2 } Old returned } <del>Long 4-1/2 x 5-1/2</del>	_____	\$ _____
<u>7</u>	Ft. <u>1</u> " in. } <del>Copper</del> } G.I. } Pipe at	_____	\$ _____
_____	Nipples _____	in. at _____	\$ _____
<u>1</u>	Bushings <u>1</u> " to <u>1/2</u> "	in. at _____	\$ _____
_____	Red'g _____		\$ _____
_____	Inc'g _____		\$ _____
_____	Union _____	in. at _____	\$ _____
_____	Meter _____	in. at _____	\$ _____
_____	Compound Joints at _____		\$ _____
_____	Maintenance Foreman _____		\$ _____
_____	Hrs. Water Maint. Man - 1 at _____		\$ _____
_____	Hrs. Water Maint. Man - 2 at _____		\$ _____
_____	Hrs. Garage Foreman _____	at _____	\$ _____
_____	Hrs. Labor _____	at _____	\$ _____
_____	Hrs. Compressor at _____		\$ _____
_____	Trucking _____		\$ _____
_____	Pav't Patch _____		\$ _____
_____			\$ _____
_____			\$ _____

FIRST

St. No. 16

Name of Owner \_\_\_\_\_

TAX ID # 309.12-8-7

Labor and Mat'l. Report OCT. 20, 1924

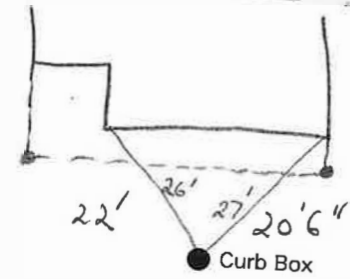

6" Main

Elev. of Main at tap 42'

Gate at ●

● Gate at

● Curb Box