

LABOR AND MATERIALS


1	Copper Lead	Connection	3/4"	\$	
1	Curb	Cock Valve T-S. & V.	3/4 in. Oriseal	\$	
1	Service box Old returned	Short 3 1/2 x 4 1/2 Long 4 1/2 x 5 1/2 Buff or Rdway		\$	
11 Ft.	3/4 in.	Copper G.I. C.I.	Pipe at	\$	
	Nipples	in. at		\$	
	Bushings	to in. at		\$	
	Red'g Inc'g	Coupl'gs. to in. at		\$	
	Union	in. at		\$	
	Meter	in. at		\$	
	Lead Joints	at		\$	
	Compound Joints	at		\$	
	Maintenance Foreman			\$	
	Hrs. Water Maint. Man-1	at		\$	
	Hrs. Water Maint. Man-2	at		\$	
	Hrs. Garage Foreman	at		\$	
	Hrs. Labor	at		\$	
	Hrs. Compressor	at		\$	
	Compensation Ins.	at \$ per C		\$	
	Trucking			\$	
	Pav't Patch			\$	
	Tap by Gifford & Co.			\$	
				\$	
				\$	
	O'head			\$	
				\$	

3-13-67.

St.
Pl. First
Ave. No. 18

Name of Owner Mesnik

Labor and Mat'l. Report Mar. 13 1967.

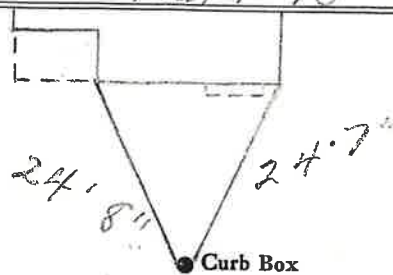

4" Main Elev. of Main at tap 5' 3"

Gate at ● ● Gate at

● Curb Box