


# LABOR AND MATERIALS

1	Copper } Connection $\frac{3}{4}$	\$
1	Lead } Cock	
1	Curb } Valve } $\frac{3}{4}$ in.	\$
	J.G. & V. }	
1	Service box { Short 3-1/2 x 4-1/2 }	\$
	Old returned { Long 4-1/2 x 5-1/2 }	
11	Ft. $\frac{3}{4}$ in. { Copper } Pipe at	\$
	Nipples _____ in. at	\$
1	Bushings $\frac{3}{4}$ to $\frac{1}{2}$ in. at	\$
	Red'g _____	
	Inc'g _____	
	Union _____ in. at	\$
	Meter _____ in. at	\$
	Compound Joints at	\$
	Maintenance Foreman _____	\$
	Hrs. Water Maint. Man - 1 at	\$
	Hrs. Water Maint. Man - 2 at	\$
	Hrs. Garage Foreman _____ at	\$
	Hrs. Labor _____ at	\$
	Hrs. Compressor at	\$
	Trucking _____	\$
	Pav't Patch _____	\$
		\$
		\$
St. FIRST  
 Ave. No. 24  
 Name of Owner \_\_\_\_\_

Labor and Mat'l. Report APR. 16, 1928

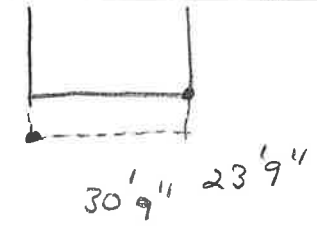

● Curb Box  
 6" Main      Elev. of Main at tap 4'  
 Gate at ●      ● Gate at

● Curb Box  
 OLD TAP SHUT OFF