


LABOR AND MATERIALS

3/4	Copper	Connection	\$
	Lead		
3/4	Curb	Cock Valve T.S. & V. in.	\$
1	Service box	Short 3 1/2 x 4 1/2	\$
	Old returned	Long 4 1/2 x 5 1/2	
		Buff or Rdway	
24 1/4	Ft. 3/4 in.	Copper C.I. C.I. Pipe at	\$
	Nipples	in. at	\$
	Bushings	to in. at	\$
	Red'g Inc'g	Coupl'gs to in. at	\$
	Union	in. at	\$
	Meter	in. at	\$
	Lead Joints	at	\$
	Compound Joints	at	\$
	Maintenance Foreman		\$
	Hrs. Water Maint. Man-1	at	\$
	Hrs. Water Maint. Man-2	at	\$
	Hrs. Garage Foreman	at	\$
	Hrs. Labor	at	\$
	Hrs. Compressor	at	\$
	Compensation Ins.	at \$ per C	\$
	Trucking		\$
	Pav't Patch		\$
	Measured in by Laveau. 1-21-71.		\$
	O'head		\$
			\$

First St. Pl. No. 25 Ave. No.

Name of Owner  
TAX ID # 309.12-1-11

Measured in Labor and Mat'l. Report Jan 21 19 71

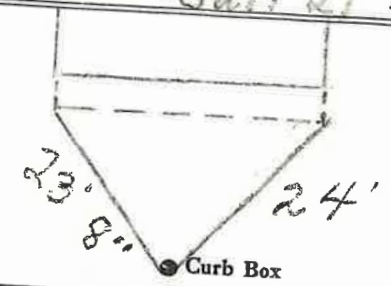

Main Elev. of Main at tap  
Gate at • Gate at •

• Curb Box

NEW 3/4" COPPER SERVICE +  
NEW CURB BOX - MAY 2000


# LABOR AND MATERIALS

_____	Copper	} Connection _____	\$ _____
_____	Lead		
_____	Curb	} _____ in. _____	\$ _____
	Cock		
	Valve		
	T.S. & V.		
_____	Service box	{ Short 3-1/2 x 4-1/2 }	\$ _____
_____	Old returned		{ Long 4-1/2 x 5-1/2 }
_____	Ft. _____ in.	{ Copper G.I. C.I. }	Pipe at _____ \$ _____
_____	Nipples _____ in.		at _____ \$ _____
_____	Bushings _____ to _____ in.		at _____ \$ _____
_____	Red'g		
_____	Inc'g		
_____	Union _____ in.	at _____	\$ _____
_____	Meter _____ in.	at _____	\$ _____
_____			\$ _____
_____	Compound Joints at _____		\$ _____
_____	Maintenance Foreman _____		\$ _____
_____	Hrs. Water Maint. Man - 1 at _____		\$ _____
_____	Hrs. Water Maint. Man - 2 at _____		\$ _____
_____	Hrs. Garage Foreman _____ at _____		\$ _____
_____	Hrs. Labor _____ at _____		\$ _____
_____	Hrs. Compressor at _____		\$ _____
_____			\$ _____
_____	Trucking _____		\$ _____
_____	Pav't Patch _____		\$ _____
_____			\$ _____
_____			\$ _____
_____			\$ _____
_____			\$ _____

First St. Pl. Ave. No. 25

Name of Owner  
**OUTSIDE CLEANOUT**

Labor and Mat'l. Report **as 12/19/17**

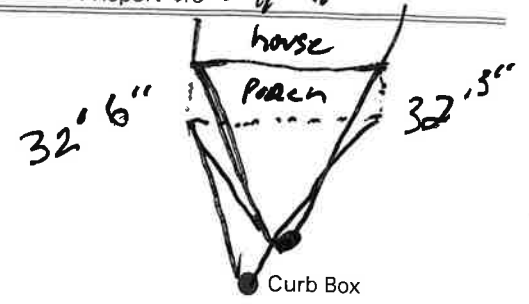

\_\_\_\_\_ Main Elev. of Main at tap \_\_\_\_\_  
Gate at ● Gate at ●

● Curb Box  
**OUTSIDE CLEANOUT**  
**JUST RIGHT OF WATER**  
**32'6" OFF HOUSES**      **32'3"**