


LABOR AND MATERIALS

1	Copper Lead	Connection	3/4	\$	
1	Curb	Cock Valve T.G. & V.	3/4 in.	\$	
1	Service box	Short 3-1/2 x 4-1/2		\$	
	Old returned	Long 4-1/2 x 5-1/2		\$	
24	Ft.	3/4 in. Copper Pipe		\$	
	Nipples		in. at	\$	
	Bushings		to in. at	\$	
	Red'g				
	Inc'g				
	Union		in. at	\$	
	Meter		in. at	\$	
				\$	
	Compound Joints		at	\$	
	Maintenance Foreman			\$	
	Hrs. Water Maint. Man - 1		at	\$	
	Hrs. Water Maint. Man - 2		at	\$	
	Hrs. Garage Foreman		at	\$	
	Hrs. Labor		at	\$	
	Hrs. Compressor		at	\$	
				\$	
	Trucking			\$	
	Pav't Patch			\$	
				\$	
				\$	
St. FIRST
Ave. No. 29
Name of Owner _____

Labor and Mat'l. Report JUNE 4, 1930

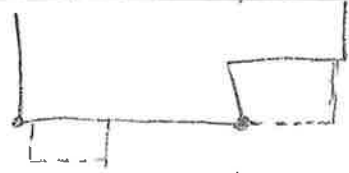

27 1/2" 29 1/2"

● Curb Box

6" Main Elev. of Main at tap 4 1/2'

Gate at ● ● Gate at

● Curb Box

OLD TAP DISCONNECTED