

LABOR AND MATERIALS


1	Copper } Connection $\frac{3}{4}$	\$
1	Lead } Cock	
1	Curb } Valve } $\frac{3}{4}$ in.	\$
	TS-CONV. }	
1	Service box { Short 3-1/2 x 4-1/2 }	\$
	Old returned { Long 4-1/2 x 5-1/2 }	
23	Ft. $\frac{3}{4}$ in. { Copper } Pipe at	\$
	Nipples _____ in. at	\$
	Bushings _____ to _____ in. at	\$
	Red'g	
	Inc'g	
	Union _____ in. at	\$
	Meter _____ in. at	\$
	Compound Joints at	\$
	Maintenance Foreman	\$
	Hrs. Water Maint. Man - 1 at	\$
	Hrs. Water Maint. Man - 2 at	\$
	Hrs. Garage Foreman _____ at	\$
	Hrs. Labor _____ at	\$
	Hrs. Compressor at	\$
	Trucking	\$
	Pav't Patch	\$
		\$
		\$
FIRST

St. No. 31

Name of Owner

Labor and Mat'l. Report AUG. 7, 1929

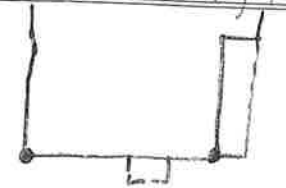

29' 10" 30' 8"

● Curb Box

6" Main

Elev. of Main at tap 5'

Gate at ●

● Gate at

● Curb Box

OLD TAP SHUT OFF - HAD TO BE DUG UP