


LABOR AND MATERIALS

1	Copper } Connection ^{3/4}	\$
1	Curb } Cock } ^{3/4} in.	\$
	} Valve }	
	} T.S. & V. }	
1	Service box { Short 3-1/2 x 4-1/2 }	\$
	Old returned { Long 4-1/2 x 5-1/2 }	
24	Ft. ^{3/4} in. { Copper } Pipe at	\$
	Nipples _____ in. at	\$
1	Bushings ^{3/4} to ^{1/2} in. at	\$
	Red'g _____	
	Inc'g _____	
	Union _____ in. at	\$
	Meter _____ in. at	\$
	_____	\$
	Compound Joints at	\$
	Maintenance Foreman _____	\$
	Hrs. Water Maint. Man - 1 at	\$
	Hrs. Water Maint. Man - 2 at	\$
	Hrs. Garage Foreman _____ at	\$
	Hrs. Labor _____ at	\$
	Hrs. Compressor at	\$
	_____	\$
	Trucking _____	\$
	Pav't Patch _____	\$
	_____	\$
	_____	\$
FIRST St. 33
 Ave. No. 33
 Name of Owner

Labor and Mat'l. Report MAY 18, 1927

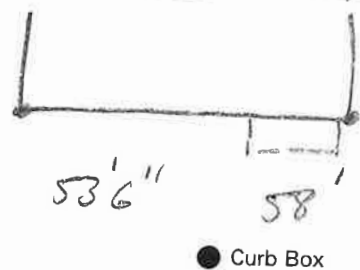

6" Main Elev. of Main at tap 4 1/2'

Gate at ● Gate at ●

TAX ID # 309.12-1-7

● Curb Box

OLD TAP SHUT OFF