


1 - 3/4" Copper to iron male adapter, New
LABOR AND MATERIALS

1 Copper Lead } Connection 3/4" New \$ -
 1 Curb } Cock Valve } 3/4" Same \$ -
 } T. S. & V. } in. \$ -
 1 Service Box } Short 3 1/2 x 4 1/2 } Same \$ -
 Old returned } Long 4 1/2 x 5 1/2 }
 } Buff or Rdway }
 23 Ft. 3/4 in. } Copper Galv Iron } Tubular 4.14
 } Cast Iron }
 Nipples in. at \$ -
 Bushings to in. at \$ -
 Red'g } Couplings 1/2 to 3/4 in. at \$ -
 Inlets }
 Union in. at \$ -
 Meter in. at \$ -
 Lead Joints at \$ -
 Leadite Joints at \$ -
 Hrs. Foreman at \$ -
 2 Hrs. Chauffeur at 6 3/4 \$ 5.50
 Hrs. Tapper at \$ -
 4 Hrs. Labor at 60 \$ 2.40
 Hrs. Labor at \$ -
 Hrs. Compressor at \$ -
 Compensation Ins. \$.18
 Trucking \$ 1.00
 Builders Use of Water \$ 12.48
 Tapp Miller \$ -
 Leak on Dept side \$ -
 Leak at curb box \$ -
 Replaced Tubelogy 25.70
 Pipe with Copper


1895
 First St. Ave. No. 37

Name of Owner Wolfe
 Renewed Pipe 5-3-61

Labor and Mat'l. Report July 22 1913

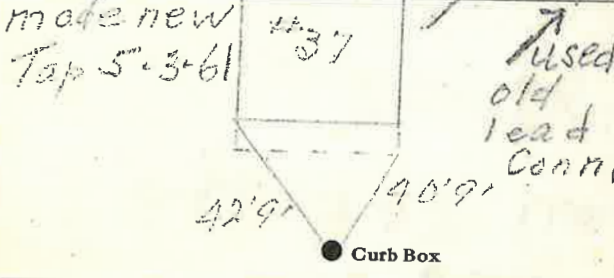

6" Main Elev. of Main at tap 5 1/2

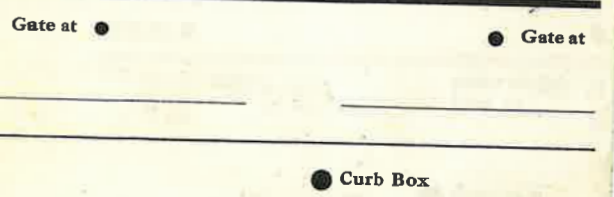

TAX ID #309.12-1-5