

LABOR AND MATERIALS


1	Copper } Connection	$\frac{3}{4}$	\$
1	Lead } Cock		
1	Curb } Valve	$\frac{3}{4}$ in.	\$
		T.S. & V.	
1	Service box	{ Short 3-1/2 x 4-1/2	\$
	Old returned	{ Long 4-1/2 x 5-1/2	
11	Ft. $\frac{3}{4}$ in. } Copper		\$
		{ Pipe at	
1	Nipples	$\frac{3}{4}$ in. at	\$
	Bushings	to in. at	\$
1	Red'g	1" to $\frac{3}{4}$ "	
	Inc'g		
	Union	in. at	\$
	Meter	in. at	\$
			\$
	Compound Joints at		\$
	Maintenance Foreman		\$
	Hrs. Water Maint. Man - 1 at		\$
	Hrs. Water Maint. Man - 2 at		\$
	Hrs. Garage Foreman	at	\$
	Hrs. Labor	at	\$
	Hrs. Compressor at		\$
			\$
	Trucking		\$
	Pav't Patch		\$
			\$
			\$
FIRST

St. No. 38

Name of Owner

Labor and Mat'l. Report **MAY 27, 1925**

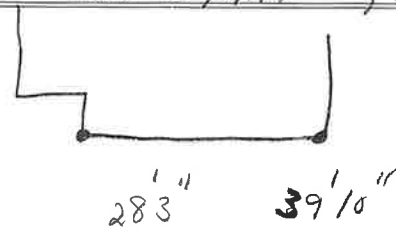

● Curb Box

6" Main

Elev. of Main at tap 4'

Gate at ●

● Gate at

● Curb Box

OLD SHUT OFF