

**LABOR AND MATERIALS**


3/4 Copper } Connection 3/4 \$ \_\_\_\_\_  
 Lead }  
 3/4 Curb } Cock } 1 in. \$ \_\_\_\_\_  
 } Valve }  
 } T.C. & V. }  
 3/4 Service box { Short 3-1/2 x 4-1/2 } \$ \_\_\_\_\_  
 Old returned { Long 4-1/2 x 5-1/2 } \$ \_\_\_\_\_  
 22 Ft. 1 in. { Copper } Pipe at Cooper \$ \_\_\_\_\_  
 } G.I. }  
 } Cast Iron }  
 \_\_\_\_\_ Nipples \_\_\_\_\_ in. at \_\_\_\_\_ \$ \_\_\_\_\_  
 \_\_\_\_\_ Bushings \_\_\_\_\_ to \_\_\_\_\_ in. at \_\_\_\_\_ \$ \_\_\_\_\_  
 \_\_\_\_\_ Red'g \_\_\_\_\_  
 \_\_\_\_\_ Inc'g \_\_\_\_\_  
 \_\_\_\_\_ Union \_\_\_\_\_ in. at \_\_\_\_\_ \$ \_\_\_\_\_  
 \_\_\_\_\_ Meter \_\_\_\_\_ in. at \_\_\_\_\_ \$ \_\_\_\_\_  
 \_\_\_\_\_ \$ \_\_\_\_\_  
 \_\_\_\_\_ Compound Joints at \_\_\_\_\_ \$ \_\_\_\_\_  
 \_\_\_\_\_ Maintenance Foreman \_\_\_\_\_ \$ \_\_\_\_\_  
 \_\_\_\_\_ Hrs. Water Maint. Man - 1 at \_\_\_\_\_ \$ \_\_\_\_\_  
 \_\_\_\_\_ Hrs. Water Maint. Man - 2 at \_\_\_\_\_ \$ \_\_\_\_\_  
 \_\_\_\_\_ Hrs. Garage Foreman \_\_\_\_\_ at \_\_\_\_\_ \$ \_\_\_\_\_  
 \_\_\_\_\_ Hrs. Labor \_\_\_\_\_ at \_\_\_\_\_ \$ \_\_\_\_\_  
 \_\_\_\_\_ Hrs. Compressor at \_\_\_\_\_ \$ \_\_\_\_\_  
 \_\_\_\_\_ \$ \_\_\_\_\_  
 \_\_\_\_\_ Trucking \_\_\_\_\_ \$ \_\_\_\_\_  
 \_\_\_\_\_ Pav't Patch \_\_\_\_\_ \$ \_\_\_\_\_  
 \_\_\_\_\_ \$ \_\_\_\_\_  
 \_\_\_\_\_ \$ \_\_\_\_\_  
FIRST

St.   
 Ass. No. 39

Name of Owner  
TAX ID # 309.12-1-4

Labor and Mat'l. Report SEPT. 10, 1924

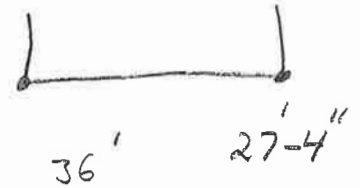

● Curb Box

6" Main

Elev. of Main at tap 4 1/2'

Gate at ● Gate at ●

● Curb Box

NEW TAP 3/4  
6-22-05