

LABOR AND MATERIALS


1	Copper } Connection	$\frac{3}{4}$	\$
1	Curb } Cock Valve	$\frac{3}{4}$ in.	\$
1	Service box } Short 3-1/2 x 4-1/2		\$
	Old returned } long 4-1/2 x 5-1/2		\$
11	Ft. $\frac{3}{4}$ in. } Copper		\$
	Nipples	in. at	\$
1	Bushings	$\frac{1}{2}$ to $\frac{3}{4}$ in. at	\$
	Red'g		\$
	Inc'g		\$
	Union	in. at	\$
	Meter	in. at	\$
	Compound Joints at		\$
	Maintenance Foreman		\$
	Hrs. Water Maint. Man - 1 at		\$
	Hrs. Water Maint. Man - 2 at		\$
	Hrs. Garage Foreman	at	\$
	Hrs. Labor	at	\$
	Hrs. Compressor at		\$
	Trucking		\$
	Pav't Patch		\$
			\$
			\$
FIRST

St. No. 40

Name of Owner

Labor and Mat'l. Report AUG. 22, 1930

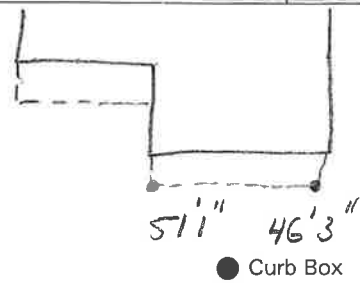

6" Main

Elev. of Main at tap 5 1/2'

Gate at ●

● Gate at

● Curb Box

OLD TAP DISCONNECTED