


LABOR AND MATERIALS

1	Copper } Connection $\frac{3}{4}$	\$
1	Curb } Cock Valve } $\frac{3}{4}$ in.	\$
1	Service box { Short 3-1/2 x 4-1/2 } Old returned { Long 4-1/2 x 5-1/2 }	\$
12	Ft. $\frac{3}{4}$ in. { Copper } Pipe at	\$
	Nipples _____ in. at	\$
	Bushings _____ to _____ in. at	\$
	Red'g	
	Inc'g	
	Union _____ in. at	\$
	Meter _____ in. at	\$
	Compound Joints at	\$
	Maintenance Foreman	\$
	Hrs. Water Maint. Man - 1 at	\$
	Hrs. Water Maint. Man - 2 at	\$
	Hrs. Garage Foreman _____ at	\$
	Hrs. Labor _____ at	\$
	Hrs. Compressor at	\$
	Trucking	\$
	Pav't Patch	\$
		\$
		\$
St. REAR
 Ave. No. 40-A
FIRST
 Name of Owner _____

Labor and Mat'l. Report JULY 22, 1930

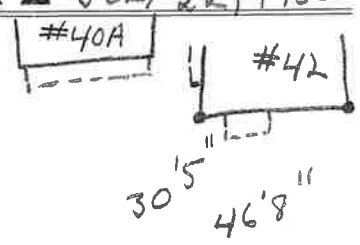

● Curb Box
 6" Main Elev. of Main at tap 5'
 Gate at ● ● Gate at

● Curb Box
 NEW TAP FOR A NEW HOUSE -
 CURB BOX FOR 40A MEASURED
 IN FROM #42