


LABOR AND MATERIALS

1	Copper } Connection	3/4	\$
1	Lead } Cock		
	Curb } Valve	3/4 in.	\$
		T.S. & V.	
	Service box	{ Short 3-1/2 x 4-1/2 }	\$
	Old returned	{ Long 4-1/2 x 5-1/2 }	\$
12	Ft. 3/4 in. } Copper	Pipe at	\$
	Nipples	in. at	\$
	Bushings	to in. at	\$
	Red'g		
	Inc'g		
	Union	in. at	\$
	Meter	in. at	\$
			\$
	Compound Joints at		\$
	Maintenance Foreman		\$
	Hrs. Water Maint. Man - 1 at		\$
	Hrs. Water Maint. Man - 2 at		\$
	Hrs. Garage Foreman	at	\$
	Hrs. Labor	at	\$
	Hrs. Compressor at		\$
			\$
	Trucking		\$
	Pav't Patch		\$
			\$
			\$
St. FIRST
 Ave. No. 42
 Name of Owner _____

Labor and Mat'l. Report OCT. 23, 1929

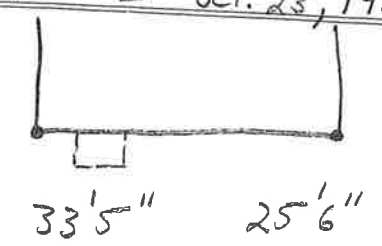

● Curb Box

6" Main
 Elev. of Main at tap 5 1/2'
 Gate at ● ● Gate at

● Curb Box

OLD TAP DISCONNECTED