


# LABOR AND MATERIALS

1	Copper <del>Lead</del>	} Connection	3/4"	\$	_____
1	Curb	{ Cock Valve Reg-Sub. }	3/4" in.	\$	_____
1	Service box Old returned	{ Short 3-1/2 x 4-1/2 Long 4-1/2 x 5-1/2 }		\$	_____
25	Ft. 3/4"	{ Copper Pipe }		\$	_____
_____	Nipples	_____ in. at		\$	_____
_____	Bushings	_____ to _____ in. at		\$	_____
_____	Red'g			\$	_____
_____	Inc'g			\$	_____
_____	Union	_____ in. at		\$	_____
_____	Meter	_____ in. at		\$	_____
_____				\$	_____
_____	Compound Joints at			\$	_____
_____	Maintenance Foreman			\$	_____
_____	Hrs. Water Maint. Man - 1 at			\$	_____
_____	Hrs. Water Maint. Man - 2 at			\$	_____
_____	Hrs. Garage Foreman	_____ at		\$	_____
_____	Hrs. Labor	_____ at		\$	_____
_____	Hrs. Compressor at			\$	_____
_____				\$	_____
_____	Trucking			\$	_____
_____	Pav't Patch			\$	_____
_____				\$	_____
_____				\$	_____
St. FIRST Ave. No. 45  
 Name of Owner BURT WELLS  
 Labor and Mat'l. Report MAY 6, 1937

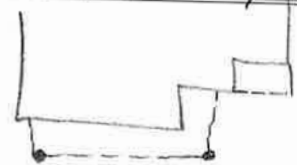

20'1" 24'11"

● Curb Box

6" Main Elev. of Main at tap 4'  
 Gate at ● Gate at ●

TAX ID # 309.11-6-12

● Curb Box

OLD TAP SHUT OFF