


# LABOR AND MATERIALS

1	Copper Lead } Connection	3/4"	\$	_____
1	Curb } Cock Valve } T.S. & V. }	1" in.	\$	_____
1	Service box } Old returned. }	{ Short 3-1/2 x 4-1/2 } { Long 4-1/2 x 5-1/2 }	\$	_____
9	Ft. 1" in. } Copper G.I. } S.I. }	Pipe at	\$	_____
_____	Nipples _____ in.	at _____	\$	_____
_____	Bushings _____ to _____ in.	at _____	\$	_____
_____	Red'g			_____
_____	Inc'g			_____
_____	Union _____ in.	at _____	\$	_____
_____	Meter _____ in.	at _____	\$	_____
_____	Compound Joints at _____		\$	_____
_____	Maintenance Foreman _____		\$	_____
_____	Hrs. Water Maint. Man - 1 at _____		\$	_____
_____	Hrs. Water Maint. Man - 2 at _____		\$	_____
_____	Hrs. Garage Foreman _____ at _____		\$	_____
_____	Hrs. Labor _____ at _____		\$	_____
_____	Hrs. Compressor at _____		\$	_____
_____	Trucking _____		\$	_____
_____	Pav't Patch _____		\$	_____
_____			\$	_____
_____			\$	_____
St. FIRST  
~~Pl.~~ Ave. No. 46  
 Name of Owner \_\_\_\_\_

Labor and Mat'l. Report ~~18~~ MAY 12, 1925

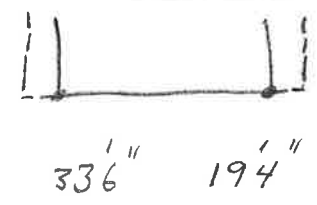

● Curb Box

\_\_\_\_\_ Main Elev. of Main at tap \_\_\_\_\_

Gate at ● \_\_\_\_\_ ● Gate at \_\_\_\_\_

● Curb Box