


LABOR AND MATERIALS

1	Copper } Connection	3/4"	\$
	Lead } Cock		
1	Curb } Valve	3/4" in.	\$
		F.S. & V.	
1	Service box } Short 3-1/2 x 4-1/2		\$
	Old returned } Long 4-1/2 x 5-1/2		
24	Ft. 3/4 in. { Copper } Pipe at		\$
		Gal. St.	
	Nipples	in. at	\$
	Bushings	to in. at	\$
1	Req'd X COUPLINGS BRASS		
	Inc'g		
	Union	in. at	\$
	Meter	in. at	\$
			\$
	Compound Joints at		\$
	Maintenance Foreman		\$
	Hrs. Water Maint. Man - 1 at		\$
	Hrs. Water Maint. Man - 2 at		\$
	Hrs. Garage Foreman	at	\$
	Hrs. Labor	at	\$
	Hrs. Compressor at		\$
			\$
	Trucking		\$
	Pav't Patch		\$
			\$
			\$
St. FIRST Ave. No. 48
 Name of Owner _____

Labor and Mat'l. Report 19 SEPT. 22, 1927

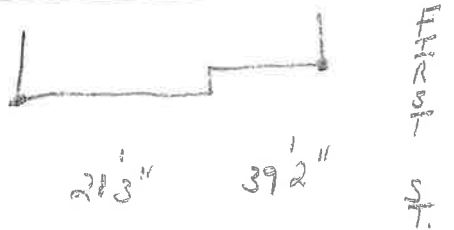

● Curb Box
 BIG CROSS ST
 4" Main Elev. of Main at tap 52'
 Gate at ● Gate at ●

● Curb Box
 NEW TAP
 TAP ON BIG CROSS