


LABOR AND MATERIALS

<u>1</u>	Copper } Connection	<u>3/4"</u>	\$	_____
<u>1</u>	Lead } Cock		\$	_____
<u>1</u>	Curb } Valve	<u>3/4"</u> in.	\$	_____
			\$	_____
<u>1</u>	Service box	{ Short 3-1/2 x 4-1/2	\$	_____
	Old returned	{ Long 4-1/2 x 5-1/2	\$	_____
<u>12</u>	Ft. <u>3/4</u> in. { Copper		\$	_____
		{ Gal. }	\$	_____
		{ Gal. }	\$	_____
	Nipples	_____ in. at _____	\$	_____
	Bushings	_____ to _____ in. at _____	\$	_____
	Red'g		\$	_____
	Inc'g		\$	_____
	Union	_____ in. at _____	\$	_____
	Meter	_____ in. at _____	\$	_____
			\$	_____
	Compound Joints at _____		\$	_____
	Maintenance Foreman _____		\$	_____
	Hrs. Water Maint. Man - 1 at _____		\$	_____
	Hrs. Water Maint. Man - 2 at _____		\$	_____
	Hrs. Garage Foreman _____ at _____		\$	_____
	Hrs. Labor _____ at _____		\$	_____
	Hrs. Compressor at _____		\$	_____
			\$	_____
	Trucking _____		\$	_____
	Pav't Patch _____		\$	_____
			\$	_____
			\$	_____
St. FIRST
 Ass. No. 50
 Name of Owner _____

Labor and Mat'l. Report 13 AUG 31, 1927

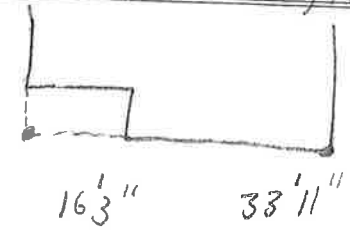

● Curb Box

6" Main
 Elev. of Main at tap 5'
 Gate at ● ● Gate at

● Curb Box

OLD TAP SHUT OFF