

## LABOR AND MATERIALS


Copper	} Connection	.....	\$			
Lead						
Curb	{ Clock	.....	\$			
	{ Valve	..... in.				
	{ T. S. & V. }					
Service box	} Short 3"X4"	} .....	\$			
Old returned					Long 4"X5"	
					Buff or Rdway	
20 Ft.	} <del>Copper</del>	} <del>Cast Iron</del>	\$	} <b>PLASTIC</b> Pipe at		
..... in.						
Nipples	..... in. at	.....	\$			
Bushings	..... to	..... in. at	\$			
Red'g	} Couplings	..... to	..... in. at	\$		
Inc'g						
Union	..... in. at	.....	\$			
Meter	..... in. at	.....	\$			
Lead Joints	at	.....	\$			
Compound Joints	at	.....	\$			
Hrs. Foreman	at	.....	\$			
Hrs. Chauffeur	at	.....	\$			
Hrs. Tapper	at	.....	\$			
Hrs. Labor	at	.....	\$			
Hrs. Labor	at	.....	\$			
Hrs. Compressor	at	.....	\$			
Compensation Ins.	.....	.....	\$			
Trucking	.....	.....	\$			
Builders Use of Water	.....	.....	\$			
<i>Measured by Makins &amp; Co.</i>						
			\$			
			\$			
First

St.  
Pl.  
Ave. No. 8

Name of Owner \_\_\_\_\_

Labor and Mat'l. Report Dec 11 19 45

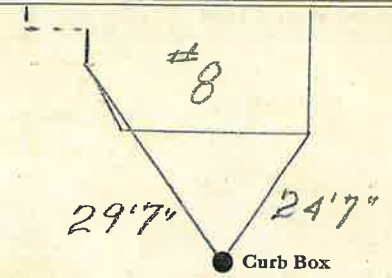

Main Elev. of  
Main at tap

---

Gate at ● ● Gate at

● Curb Box

F-24-16 - REPLACED GALV NIPPLES  
OUR SIDE W/ PLASTIC  
REPLACED SEWER  
OUR SIDE W/ PLASTIC  
INSTALLED OUTSIDE  
CLEANOUT