


LABOR AND MATERIALS

1 Copper } Connection 3/4 \$ _____
 Lead }
 1 Curb } Cock } _____ in. \$ _____
 Valve }
 Tr.S. & V. }
 1 Service box { Short 3-1/2 x 4-1/2 } \$ _____
 Old returned { Long 4-1/2 x 5-1/2 }
 25 Ft. 3/4 in. { Copper } Pipe at _____ \$ _____
 Nipples _____ in. at _____ \$ _____
 1 Bushings 1/2 to 3/4 in. at _____ \$ _____
 Red'g _____
 Inc'g _____
 Union _____ in. at _____ \$ _____
 Meter _____ in. at _____ \$ _____
 _____ \$ _____
 Compound Joints at _____ \$ _____
 Maintenance Foreman _____ \$ _____
 Hrs. Water Maint. Man - 1 at _____ \$ _____
 Hrs. Water Maint. Man - 2 at _____ \$ _____
 Hrs. Garage Foreman _____ at _____ \$ _____
 Hrs. Labor _____ at _____ \$ _____
 Hrs. Compressor at _____ \$ _____
 _____ \$ _____
 Trucking _____ \$ _____
 Pav't Patch _____ \$ _____
 _____ \$ _____
 _____ \$ _____
 _____ \$ _____
 _____ \$ _____

St. _____
FIRST Ave. No. 51
 Name of Owner _____

Labor and Mat'l. Report 19 JUNE 28, 1929

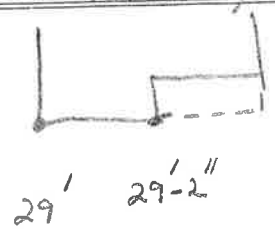

● Curb Box

4" Main Elev. of Main at tap 5'
 Gate at ● Gate at ●

● Curb Box

OLD TAP. SHUT OFF

LABOR AND MATERIALS

Copper } Connection _____ \$ _____
 Lead }
 Curb } Cock _____ in. _____ \$ _____
 } Valve _____
 } T.S. & V. }
 Service box { Short 3-1/2 x 4-1/2 } _____ \$ _____
 Old returned { Long 4-1/2 x 5-1/2 }
 Ft. _____ in. { Copper } Pipe at _____ \$ _____
 } G.I. }
 } C.I. }
 Nipples _____ in. at _____ \$ _____
 Bushings _____ to _____ in. at _____ \$ _____
 Red'g _____
 Inc'g _____
 Union _____ in. at _____ \$ _____
 Meter _____ in. at _____ \$ _____
 _____ \$ _____
 _____ \$ _____
 Compound Joints at _____ \$ _____
 Maintenance Foreman _____ \$ _____
 Hrs. Water Maint. Man - 1 at _____ \$ _____
 Hrs. Water Maint. Man - 2 at _____ \$ _____
 Hrs. Garage Foreman _____ at _____ \$ _____
 Hrs. Labor _____ at _____ \$ _____
 Hrs. Compressor at _____ \$ _____
 _____ \$ _____
 _____ \$ _____
 Trucking _____ \$ _____
 Pav't Patch _____ \$ _____
 _____ \$ _____
 _____ \$ _____
 _____ \$ _____
 _____ \$ _____


St. _____
Pl. _____
Ave. No. 51

FIRST ST.

Name of Owner _____

(CORNER OF FIRST & NEW)

Labor and Mat'l. Report 19

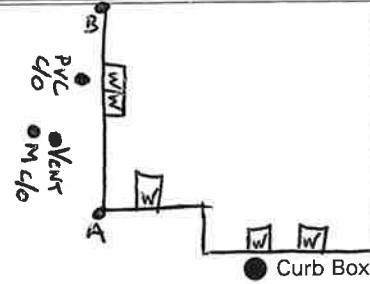

OUTSIDE CLEANOUTS

_____ Main

Elev. of
Main at tap _____

Gate at ●

● Gate at _____

● Curb Box

PVC c/o - A - 22'
B - 15'

VENT/M c/o - A - 15.6'
B - 22'