


**LABOR AND MATERIALS**

|    |                       |  |                             |            |         |    |
|----|-----------------------|--|-----------------------------|------------|---------|----|
| 1  | Copper                | Connection                               | $\frac{3}{4}$               | \$         | 1.23    |    |
| 1  | Curb                  | Cock Valve T. S. & V.                    | $\frac{3}{4}$ in.           | \$         | 1.68    |    |
| 1  | Service Box           | Short $3\frac{1}{2} \times 4\frac{1}{2}$ | }                           | \$         | 1.54    |    |
|    | Old returned          | Long $4\frac{1}{2} \times 5\frac{1}{2}$  |                             |            |         |    |
| 11 | Ft.                   | $\frac{3}{4}$ in.                        | Copper Galv. Iron Cast Iron | Pipe at 17 | \$ 1.87 |    |
|    | Nipples               | in.                                      | at                          | \$         |         |    |
|    | Bushings              | to                                       | in.                         | at         | \$      |    |
|    | Red'g Inc'g           | Couplings                                | to                          | in.        | at      | \$ |
|    | Union                 | in.                                      | at                          | \$         |         |    |
|    | Meter                 | in.                                      | at                          | \$         |         |    |
|    | Lead Joints           | at                                       | \$                          |            |         |    |
|    | Leadite Joints        | at                                       | \$                          |            |         |    |
|    | Hrs. Foreman          | at                                       | \$                          |            |         |    |
| 2  | Hrs. Chauffeur        | at                                       | $6\frac{1}{2}$              | \$         | 1.25    |    |
| 7  | Hrs. Tapper           | at                                       |                             | \$         | 4.38    |    |
| 7  | Hrs. Labor            | at                                       | 45                          | \$         | 3.15    |    |
|    | Hrs. Labor            | at                                       |                             | \$         |         |    |
|    | Hrs. Compressor       | at                                       |                             | \$         |         |    |
|    | Compensation Ins.     |  |                             | \$         | .27     |    |
|    | Trucking              |  |                             | \$         | 1.-     |    |
|    | Builders Use of Water | Patch                                    |                             | \$         | 5.-     |    |
|    | Tap by Hessel         |  |                             | \$         |         |    |
|    |                       |  |                             | \$         |         |    |
|    |                       |  |                             | \$         |         |    |
|    |                       |  |                             | \$         |         |    |
|    |                       |  |                             | \$         |         |    |
|    |                       |  |                             | \$         | 21.37   |    |

8 3 - - 1939 St. ~~Pr.~~  
 First Ave. No. 52

Name of Owner Kopelovitz

Labor and Mat'l. Report Oct 5 1939

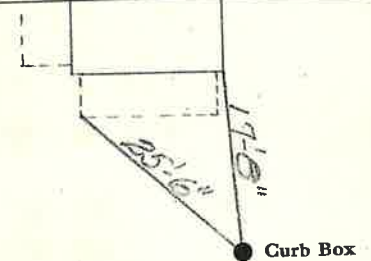

6 Main Elev. of Main at tap 51'  
 Gate at ● ● Gate at

● Curb Box

old shut off