

LABOR AND MATERIALS

1	Copper Lead	{ Connection	3/4"		\$ 2.29
1	Curb	{ Cock Valve T.S. & V.	3/4" in.		\$ 2.70
1	Service box Old returned	{ Short 3 1/2 x 4 1/2 Long 4 1/2 x 5 1/2 Buff or Rdway			\$ 4.25
266	Ft. 3/4 in.	{ Copper G.I. C.I.	Pipe at 35		\$ 9.10
	Nipples	in. at			\$
	Bushings	to in. at			\$
	Red'g Inc'g	{ Coupl'gs to in. at			\$
	Union	in. at			\$
	Meter	in. at			\$
	Lead Joints at				\$
	Compound Joints at				\$
3	Hrs. Water Maint. Man-1 at	1.12			\$ 3.36
6	Hrs. Water Maint. Man-2 at	1.02			\$ 6.12
16	Hrs. Labor at	.91			\$ 14.56
	Hrs. Labor at				\$
	Hrs. Compressor at				\$
	Compensation Ins. at \$	per C.			\$ 54
	Trucking				\$ 1.50
	Pav't Patch	B.P.			\$
	O'head				\$
					\$43.92

162-1950

Before Taping

First


St. Pl- Ave. No. 53

Name of Owner

Fred Hayes

Labor and Mat'l. Report

July 21 1950

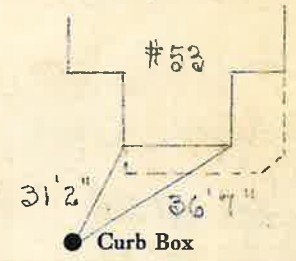

6" Main

Elev. of Main at tap 5'

Gate at ●

● Gate at

● Curb Box