

LABOR AND MATERIALS


1	Copper	{ Connection	3/4"	\$	2.24
1	Lead	{			
1	Curb	{ Cock Valve T.S. & V. }	3/4" in.	\$	2.70
1	Service box	{ Short 3 1/2 x 4 1/2 }			
	Old returned	{ Long 4 1/2 x 5 1/2 }			
		{ Buff or Rdway }		\$	4.25
11	Ft.	{ Copper G.I. C.I. }	3/4 in. Pipe at 35	\$	3.85
	Nipples	in. at		\$	
	Bushings	to in. at		\$	
	Red'g	{ Coupl'gs to in. at		\$	
	Inc'g			\$	
	Union	in. at		\$	
	Meter	in. at		\$	
	Lead Joints at			\$	16.33
	Compound Joints at			\$	
2	Hrs. Water Maint. Man-1 at			\$	2.24
4	Hrs. Water Maint. Man-2 at			\$	4.08
11	Hrs. Labor— at	91		\$	10.01
	Hrs. Labor— at			\$	
	Hrs. Compressor at			\$	
	Compensation Ins. at \$	per C.		\$	36
	Trucking			\$	1.—
	Pav't Patch	B.P.		\$	—
				\$	
				\$	
				\$	
	O'head			\$	
				\$	30.78

163-1954

Before Paving

St. Pl-
First
 Ave. No. 54
 Name of Owner
Gerald Bolster

Labor and Mat'l. Report July 30 19 50

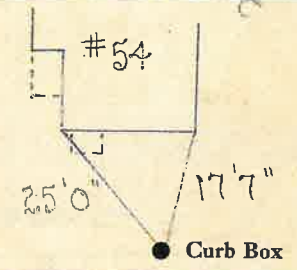

6" Main Elev. of Main at tap 5'
 Gate at ● Gate at ●

● Curb Box