


LABOR AND MATERIALS

1	Copper } Connection		\$	
1	Lead } Cock		\$	
1	Curb } Valve	_____ in.	\$	
		_____ in.	\$	
1	Service box { Short 3-1/2 x 4-1/2		\$	
	Old returned { long 4-1/2 x 5-1/2		\$	
10	Ft. 3/4 in. { Copper		\$	
		_____ in. at _____	\$	
	Nipples	_____ in. at _____	\$	
	Bushings	_____ to _____ in. at _____	\$	
	Red'g		\$	
	Inc'g		\$	
	Union	_____ in. at _____	\$	
	Meter	_____ in. at _____	\$	
			\$	
	Compound Joints at		\$	
	Maintenance Foreman		\$	
	Hrs. Water Maint. Man - 1 at		\$	
	Hrs. Water Maint. Man - 2 at		\$	
	Hrs. Garage Foreman	_____ at _____	\$	
	Hrs. Labor	_____ at _____	\$	
	Hrs. Compressor at		\$	
			\$	
	Trucking		\$	
	Pav't Patch		\$	
			\$	
			\$	
St. FIRST Ave. No. 56

Name of Owner _____

Labor and Mat'l. Report AUG. 1925

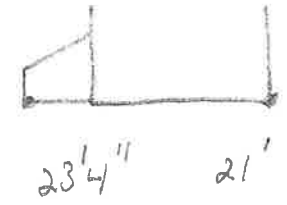

● Curb Box

_____ Main Elev. of Main at tap _____

Gate at ● ● Gate at

● Curb Box