

# LABOR AND MATERIALS


|    |                                   |           |    |
|----|-----------------------------------|-----------|----|
| 1  | Copper } Connection               | 3/4       | \$ |
| 1  | Lead } Cock                       |           | \$ |
| 1  | Curb } Valve                      | 3/4 in.   | \$ |
|    |                                   | T.S. & V. |    |
| 1  | Service box } Short 3-1/2 x 4-1/2 |           | \$ |
|    | Old returned } Long 4-1/2 x 5-1/2 |           | \$ |
| 26 | Ft. 3/4 in. } Copper              |           | \$ |
|    |                                   | CS.       |    |
|    |                                   | CS.       |    |
|    | Nipples                           | in. at    | \$ |
|    | Bushings                          | to in. at | \$ |
|    | Red'g                             |           | \$ |
|    | Inc'g                             |           | \$ |
|    | Union                             | in. at    | \$ |
|    | Meter                             | in. at    | \$ |
|    | Compound Joints at                |           | \$ |
|    | Maintenance Foreman               |           | \$ |
|    | Hrs. Water Maint. Man - 1 at      |           | \$ |
|    | Hrs. Water Maint. Man - 2 at      |           | \$ |
|    | Hrs. Garage Foreman at            |           | \$ |
|    | Hrs. Labor at                     |           | \$ |
|    | Hrs. Compressor at                |           | \$ |
|    | Trucking                          |           | \$ |
|    | Pav't Patch                       |           | \$ |
|    |                                   |           | \$ |
|    |                                   |           | \$ |
FIRST

St. No. 57

Name of Owner

Labor and Mat'l. Report JUNE 6, 1933

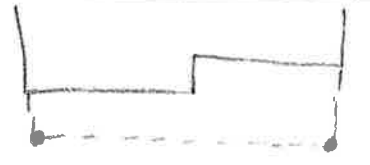

25' 29 6/8"

● Curb Box

6" Main

Elev. of Main at tap 5"

Gate at ● Gate at ●

● Curb Box

OLD TAP SHUT OFF AT MAIN