

LABOR AND MATERIALS

1	Copper Lead	{ Connection	3/4	\$	2.29
1	Curb	{ Cock Valve F.S. & V. }	3/4 in.	\$	2.70
1	Service box Old returned	{ Short 3 1/2 x 4 1/2 Long 4 1/2 x 5 1/2 Buff or Rdway }	New Rod	\$	4.25
11	Ft. 3/4 in.	{ Copper G.I. C.I. }	Pipe at	35	\$ 3.85
	Nipples	in. at		\$	
	Bushings	to in. at		\$	
	Red'g Inc'g	{ Coupl'gs	to in. at	\$	
	Union	in. at		\$	
	Meter	in. at		\$	
	Lead Joints at			\$	1.63
	Compound Joints at			\$	
2	Hrs. Water Maint. Man-1 at		1.12	\$	2.24
4	Hrs. Water Maint. Man-2 at		1.07	\$	4.28
11	Hrs. Labor— at		91	\$	10.01
	Hrs. Labor— at			\$	
	Hrs. Compressor at			\$	
	Compensation Ins. at \$			per C.	\$ 26
	Trucking			\$	1.00
	Pav't Patch	B.P.		\$	
				\$	
				\$	
				\$	
	O'head			\$	
					\$ 30.78

164-1950

Before Taving

First

St.
Pl-


Ava No. 58

Name of Owner

James Webb

Labor and Mat'l. Report

July 20 1950

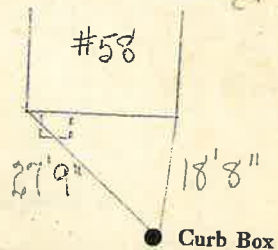

6" Main

Elev. of
Main at tap 5'

Gate at ●

● Gate at

● Curb Box

LABOR AND MATERIALS


_____	Copper } Connection _____	\$ _____
_____	Lead } _____	\$ _____
_____	Curb } Cock _____	\$ _____
_____	} Valve _____	\$ _____
_____	} T.S. & V. _____	\$ _____
_____	Service box { Short 3-1/2 x 4-1/2 } _____	\$ _____
_____	Old returned { Long 4-1/2 x 5-1/2 } _____	\$ _____
_____	Ft. _____ in. { Copper } Pipe at _____	\$ _____
_____	} G.I. _____	\$ _____
_____	} C.I. _____	\$ _____
_____	Nipples _____ in. at _____	\$ _____
_____	Bushings _____ to _____ in. at _____	\$ _____
_____	Red'g _____	\$ _____
_____	Inc'g _____	\$ _____
_____	Union _____ in. at _____	\$ _____
_____	Meter _____ in. at _____	\$ _____
_____	Compound Joints at _____	\$ _____
_____	Maintenance Foreman _____	\$ _____
_____	Hrs. Water Maint. Man - 1 at _____	\$ _____
_____	Hrs. Water Maint. Man - 2 at _____	\$ _____
_____	Hrs. Garage Foreman _____ at _____	\$ _____
_____	Hrs. Labor _____ at _____	\$ _____
_____	Hrs. Compressor at _____	\$ _____
_____	Trucking _____	\$ _____
_____	Pav't Patch _____	\$ _____
_____	_____	\$ _____
_____	_____	\$ _____
St. _____
Pl. _____
Ave. No. _____

Name of Owner _____

58 FIRST ST

Labor and Mat'l. Report 19

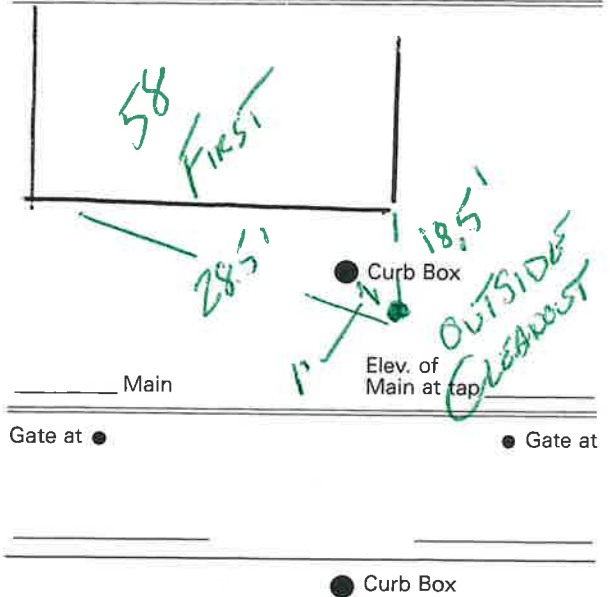

Gate at ●

● Gate at

● Curb Box