

### LABOR AND MATERIALS

1	Copper head	Connection	3/4"		\$ 2.29
1	Curb	Cock Valve F.S. & V.	3/4 in.		\$ 2.70
1	Service box Old returned	Short 3 1/2 x 4 1/2 Long 4 1/2 x 5 1/2 Buff or Rdway	New Rod		\$ 4.25
26	Ft.	3/4 in.	Copper G.I. G.I.	Pipe at 35	\$ 9.10
	Nipples	in. at			\$
	Bushings	to in. at			\$
	Red'g Ine'g	Coupl'gs to in. at			\$
	Union	in. at			\$
	Meter	in. at			\$
	Lead Joints at				\$ 1.40
	Compound Joints at				\$
3	Hrs. Water Maint. Man-1	at 1.12			\$ 3.36
6	Hrs. Water Maint. Man-2	at 1.02			\$ 6.12
16	Hrs. Labor	at 91			\$ 14.56
	Hrs. Labor	at			\$
	Hrs. Compressor at				\$
	Compensation Ins. at \$	per C.			\$ 1.54
	Trucking				\$
	Pav't Patch	B.P.			\$
	O'head				\$
					\$ 43.92

115-1100


Before Paving

St.  
Pl.  
Ave. No. 59

First

Name of Owner  
Albert Buckbee

Labor and Mat'l. Report July 21 19 50

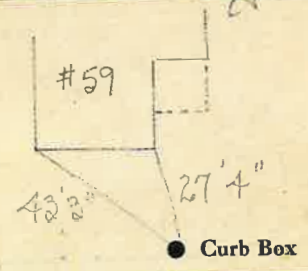

6" Main Elev. of  
Main at tap 5'

Gate at ● ● Gate at

TAX ID # 309.11-6-5

● Curb Box