

LABOR AND MATERIALS


1 Copper Lead	{ Connection	3/4"	\$ 2.29
1 Curb	{ Cock Valve T.S. & V.	3/4 in.	\$ 2.70
1 Service box Old returned	{ Short 3 1/2 x 4 1/2 Long 4 1/2 x 5 1/2 Buff or Rdway		\$ 4.25
11 Ft. 3/4 in.	{ Copper C.I. C.I.	Pipe at 35	\$ 3.85
Nipples	in. at		\$
Bushings	to in. at		\$
Red'g Inc'g	{ Coupl'gs	to in. at	\$
Union	in. at		\$
Meter	in. at		\$
Lead Joints at			\$ 16.33
Compound Joints at			\$
2 Hrs. Water Maint. Man-1 at	1.12	\$ 2.24	
4 Hrs. Water Maint. Man-2 at	1.02	\$ 4.08	
11 Hrs. Labor at	91	\$ 10.01	
Hrs. Labor at		\$	
Hrs. Compressor at		\$	
Compensation Ins. at \$	per C.	\$ 36	
Trucking		\$ 1.00	
Pav't Patch	B-P	\$	
O'head		\$	
		\$	
		\$	
		\$	
		\$	
		\$ 30.78	

166-1454
Before Paving

First
St. Pt. Ave. No. 60

Name of Owner
Berman (Bldg Razed)

Labor and Mat'l. Report July 20 1950

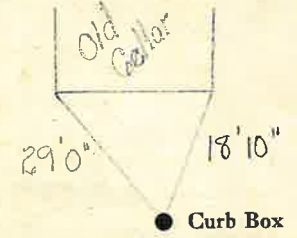

● Curb Box

6" Main Elev. of Main at tap 25'

Gate at ● ● Gate at

● Curb Box