

LABOR AND MATERIALS

1	Copper	{	Connection	3/4"	\$	2.29
1	Lead	{	Cock Valve	3/4 in.	\$	2.70
			F.S. & V.			
1	Service box	{	Short	3 1/2 x 4 1/2	\$	4.25
	Old returned		Long	4 1/2 x 5 1/2		
			Buf or Rdway			
11	Ft. 3/4 in.	{	Copper	Pipe at 35	\$	3.85
			G.I.			
			C.I.			
	Nipples	in. at			\$	
	Bushings	to in. at			\$	
	Red'g Inc'g	{ Coupl'gs to in. at			\$	
	Union	in. at			\$	
	Meter	in. at			\$	
	Lead Joints at				\$	
	Compound Joints at				\$	
2	Hrs. Water Maint. Man-1	at			\$	2.24
4	Hrs. Water Maint. Man-2	at			\$	4.08
11	Hrs. Labor	at			\$	10.01
	Hrs. Labor	at			\$	
	Hrs. Compressor at				\$	
	Compensation Ins. at \$	per C.			\$	36
	Trucking				\$	1.36
	Pav't Patch	B.P.			\$	
					\$	
					\$	
					\$	
	O'head				\$	
					\$	30.78

167-1960

Before Tarring

First


St. #1 Ave. No. 62

Name of Owner

Vivien Geroux

Labor and Mat'l. Report

July 20 1950

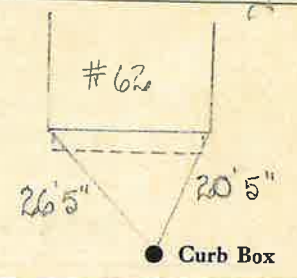

6" Main

Elev. of Main at tap 5'

Gate at ●

● Gate at

● Curb Box