


LABOR AND MATERIALS

1	Copper	} Connection	$\frac{3}{4}$ "	_____	\$ _____	
1	Lead					
1	Curb	} Cock Valve	} $\frac{3}{4}$ in.	_____	\$ _____	
						T.S. & V.
1	Service box	} {	Short $3\frac{1}{2}$ x $4\frac{1}{2}$	_____	\$ _____	
	Old returned					Long $4\frac{1}{2}$ x $5\frac{1}{2}$
						Buff or Rdway
26	Ft. $\frac{3}{4}$ in.	} {	Copper	} Pipe at _____	\$ _____	
						C.I.
						C.I.
	Nipples	_____ in. at _____			\$ _____	
	Bushings	_____ to _____ in. at _____			\$ _____	
	Red'g } Inc'g }	} Coupl'gs _____ to _____ in. at _____			\$ _____	
	Union		_____ in. at _____			\$ _____
	Meter	_____ in. at _____			\$ _____	
	Lead Joints at _____				\$ _____	
	Compound Joints at _____				\$ _____	
	Maintenance Foreman _____				\$ _____	
	Hrs. Water Maint. Man-1 at _____				\$ _____	
	Hrs. Water Maint. Man-2 at _____				\$ _____	
	Hrs. Garage Foreman _____ at _____				\$ _____	
	Hrs. Labor _____ at _____				\$ _____	
	Hrs. Compressor at _____				\$ _____	
	Compensation Ins. at \$ _____ per C				\$ _____	
	Trucking _____				\$ _____	
	Pav't Patch _____				\$ _____	
	Tap by Gifford & Co.				\$ _____	
	4-14-59.				\$ _____	
	O'head _____				\$ _____	
					\$ _____	

✓
First St. 63
Pl.
Ave. No. 63

Name of Owner
Mrs. Joseph Barinet

Labor and Mat'l. Report April 14 1959

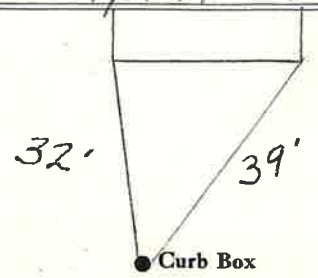

6" Main Elev. of Main at tap 5 1/2'

Gate at • • Gate at

• Curb Box