


LABOR AND MATERIALS

1	Copper } Connection	<u>3/4</u>	\$	
1	Lead } Curb	}	\$	
		Cock Valve } <u>3/4</u> in.	\$	
		T.S. & W. }		
1	Service box	{ Short 3-1/2 x 4-1/2 }	\$	
	Old returned	{ Long 4-1/2 x 5-1/2 }	\$	
11	Ft. <u>34</u> in. { Copper } Pipe at	{ 3/4 } }	\$	
	Nipples	in. at	\$	
	Bushings	to in. at	\$	
	Red'g			
	Inc'g			
	Union	in. at	\$	
	Meter	in. at	\$	
			\$	
	Compound Joints at		\$	
	Maintenance Foreman		\$	
	Hrs. Water Maint. Man - 1 at		\$	
	Hrs. Water Maint. Man - 2 at		\$	
	Hrs. Garage Foreman	at	\$	
	Hrs. Labor	at	\$	
	Hrs. Compressor at		\$	
			\$	
	Trucking		\$	
	Pav't Patch		\$	
			\$	
			\$	
St. FIRST
 Ass. No. 64

Name of Owner
 TAX ID # 309.11-7-14

Labor and Mat'l. Report MAY 7, 1929

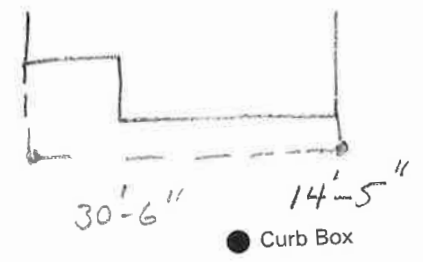

6" Main

Elev. of Main at tap 4 1/2'

Gate at ● Gate at ●

● Curb Box

OLD LEAD SHUT OFF