


LABOR AND MATERIALS

1	Copper } Connection	3/4	\$
1	Lead } Cock		
1	Curb } Valve	3/4 in.	\$
		T.S. & V.	
1	Service box { Short 3-1/2 x 4-1/2		\$
	Old returned { Long 4-1/2 x 5-1/2		\$
7	Ft. 3/4 in. { Copper		\$
		Est.	
		Est.	
	Nipples	in. at	\$
	Bushings	to in. at	\$
	Red'g		
	Inc'g		
	Union	in. at	\$
	Meter	in. at	\$
			\$
	Compound Joints at		\$
	Maintenance Foreman		\$
	Hrs. Water Maint. Man - 1 at		\$
	Hrs. Water Maint. Man - 2 at		\$
	Hrs. Garage Foreman	at	\$
	Hrs. Labor	at	\$
	Hrs. Compressor at		\$
			\$
	Trucking		\$
	Pav't Patch		\$
			\$
			\$
St. FIRST
 Ave. No. 65
 Name of Owner STUB SERVICE AT CURB FOR 65
 Labor and Mat'l. Report 19 JULY 10, 1928 *file st.*

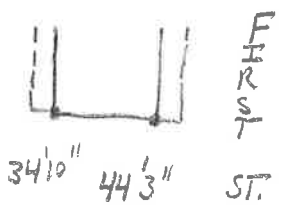

● Curb Box
 STAPLE ST
 6" Main Elev. of Main at tap 4'
 Gate at ● Gate at

● Curb Box
 NE CRN. *1st* + STAPLE
 THIS TAP ON STAPLE

LABOR AND MATERIALS

1	Copper } Connection $\frac{3}{4}$	\$ _____
1	Lead } Cock	\$ _____
1	Curb } Valve	\$ _____
	T.S. & V. } $\frac{3}{4}$ in.	\$ _____
1	Service box { Short 3-1/2 x 4-1/2 }	\$ _____
	Old returned { Long 4-1/2 x 5-1/2 }	\$ _____
25	Ft. $\frac{3}{4}$ in. { Copper } Pipe at	\$ _____
		\$ _____
	Nipples _____ in. at	\$ _____
	Bushings _____ to _____ in. at	\$ _____
	Red'g	\$ _____
	Inc'g	\$ _____
	Union _____ in. at	\$ _____
	Meter _____ in. at	\$ _____
	_____	\$ _____
	Compound Joints at	\$ _____
	Maintenance Foreman	\$ _____
	Hrs. Water Maint. Man - 1 at	\$ _____
	Hrs. Water Maint. Man - 2 at	\$ _____
	Hrs. Garage Foreman _____ at	\$ _____
	Hrs. Labor _____ at	\$ _____
	Hrs. Compressor at	\$ _____
	_____	\$ _____
	Trucking _____	\$ _____
	Pav't Patch _____	\$ _____
	_____	\$ _____
	_____	\$ _____
FIRST St. 65
Ave. No.

Name of Owner _____

Labor and Mat'l. Report MAY 15, 1934



ST. ● Curb Box

6" Main FIRST ST
Elev. of Main at tap 4 1/2

Gate at ● ● Gate at

● Curb Box
OLD TAP SHUT OFF AT MAIN