

LABOR AND MATERIALS

1	Copper	{ Connection	3/4"		\$ 2.29
	Lead				
1	Curb	{ Cock Valve	3/4 in.		\$ 2.70
		{ T.S. & V.			
1	Service box	{ Short 3 1/2 x 4 1/2			
	Old returned	{ Long 4 1/2 x 5 1/2			
		{ Buff or Rdway			\$ 4.25
11	Ft.	3/4 in.	{ Copper	Pipe at 35	\$ 3.85
			{ G.I.		
			{ C.I.		
	Nipples	in. at			\$
1	Bushings	3/4 to 1/2 in. at			\$
	Red'g	{ Coupl'gs	to in. at		\$
	Inc'g				
	Union	in. at			\$
	Meter	in. at			\$
	Lead Joints at				\$
	Compound Joints at				\$
2	Hrs. Water Maint. Man-1	at			\$ 2.24
4	Hrs. Water Maint. Man-2	at			\$ 4.08
11	Hrs. Labor	at			\$ 10.01
	Hrs. Labor	at			\$
	Hrs. Compressor at				\$
	Compensation Ins. at \$	per C.			\$ 36
	Trucking				\$ 1.00
	Pav't Patch				\$
					\$
					\$
	O'head				\$
					\$ 30.78

Before Paving

129 1950


First

St. PL. Ave. No. 68

Name of Owner

Charles Wright

Labor and Mat'l. Report July 20 19 50

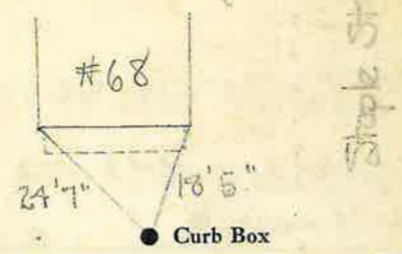

6" Main

Elev. of Main at tap 5'

Gate at ● ● Gate at

TAX ID # 309.11-7-16

● Curb Box