


From House.

Gate at ● Gate at ●
 Main Elev. of Main at tap 5- 7

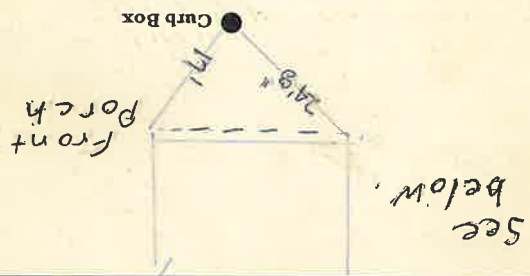

See below.

Labor and Mat'l. Report City 5- 1943

Name of Owner
 Slack

St. Pl. Ave. No. 6

85.43