


LABOR AND MATERIALS

- Connection _____ \$ _____
- Cock Valve T.S. & V. } _____ in. _____ \$ _____
- Box Short 3-1/2 x 4-1/2 } _____ \$ _____
- Box Long 4-1/2 x 5-1/2 } _____ \$ _____
- in. { Copper } Pipe at _____ \$ _____
- { G.I. } _____ \$ _____
- { C.I. } _____ \$ _____
- _____ in. at _____ \$ _____
- _____ to _____ in. at _____ \$ _____
- _____ in. at _____ \$ _____
- _____ in. at _____ \$ _____
- _____ \$ _____
- _____ and Joints at _____ \$ _____
- _____ Finance Foreman _____ \$ _____
- _____ Water Maint. Man - 1 at _____ \$ _____
- _____ Water Maint. Man - 2 at _____ \$ _____
- _____ Garage Foreman _____ at _____ \$ _____
- _____ Door _____ at _____ \$ _____
- _____ Compressor at _____ \$ _____
- _____ \$ _____
- _____ \$ _____
FLANDREAU St. Pl. Ave. No. 16

Name of Owner _____

Labor and Mat'l. Report to AUG 2012

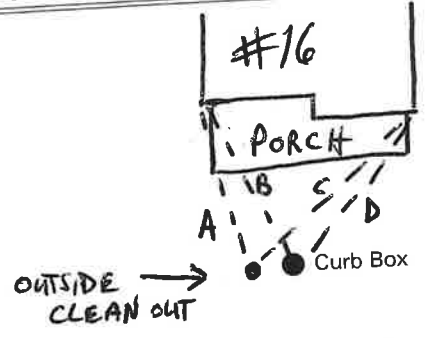

_____ Main Elev. of Main at tap 4'

Gate at ● Gate at ●

CLEAN OUT 1 FOOT SOUTH OF CURB BOX

- A = 24'
- B = 24'3"
- C = 30'
- D = 28'1"

● Curb Box