

LABOR AND MATERIALS


1	Copper	{ Connection	3/4	\$ 2.79
1	Lead	{		
		{ Cock		
		{ Valve	3/4 in.	\$ 2.70
		{ T.S. & V.		
1	Service box	{ Short 3 1/2 x 4 1/2		
	Old returned	{ Long 4 1/2 x 5 1/2		\$ 4.25
		{ Buff or Rdway		
26	Ft.	{ Copper	3/4 in.	
		{ G.I.		
		{ C.I.		
		Pipe at	35	\$ 9.10
	Nipples	in. at		\$
	Bushings	to in. at		\$
	Red'g	{ Coupl'gs to in. at		\$
	Inc'g			\$
	Union	in. at		\$
	Meter	in. at		\$
	Lead Joints at			\$
	Compound Joints at			\$
	Hrs. Water Maint. Man—1 at			\$
10 1/2	Hrs. Water Maint. Man—2 at	102		\$ 10.71
11	Hrs. Labor— at	91		\$ 10.01
	Hrs. Labor— at			\$
	Hrs. Compressor at			\$
	Compensation Ins. at \$	per C.		\$ 46
	Trucking			\$ 1.00
	Pav't Patch			\$ 15.75
	Tray by Warrinsmiller			\$
	O'head			\$
				\$ 56.27

4E-1950

Flandreau St
^H
Ave. No. *17*

Name of Owner
Crook

Labor and Mat'l. Report *May 31* 19*50*

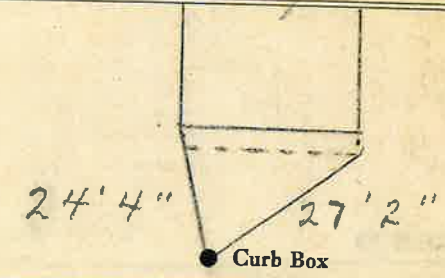

△ Main Elev. of Main at tap *3-*
Gate at ● Gate at

● Curb Box