

LABOR AND MATERIALS


| | | | |
|----|-----------------------------------|-----------|----|
| 1 | Copper } Connection | 3/4 | \$ |
| 1 | Lead } Cock | | \$ |
| 1 | Curb } Valve | 3/4 in. | \$ |
| | | T.S. & V. | |
| 1 | Service box } Short 3-1/2 x 4-1/2 | | \$ |
| | Old returned } Long 4-1/2 x 6-1/2 | | \$ |
| 27 | Ft. 3/4 in. } Copper | | \$ |
| | | Pipe at | \$ |
| | Nipples | in. at | \$ |
| | Bushings | to in. at | \$ |
| | Red'g | | \$ |
| | Inc'g | | \$ |
| | Union | in. at | \$ |
| | Meter | in. at | \$ |
| | | | \$ |
| | Compound Joints at | | \$ |
| | Maintenance Foreman | | \$ |
| | Hrs. Water Maint. Man - 1 at | | \$ |
| | Hrs. Water Maint. Man - 2 at | | \$ |
| | Hrs. Garage Foreman | at | \$ |
| | Hrs. Labor | at | \$ |
| | Hrs. Compressor at | | \$ |
| | | | \$ |
| | Trucking | | \$ |
| | Pav't Patch | | \$ |
| | | | \$ |
| | | | \$ |
FLANDREAUX

Ave. No. 9

Name of Owner

Labor and Mat'l. Report 19 OCT. 19, 1927

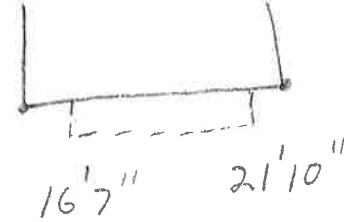

● Curb Box

4" Main

Elev. of Main at tap 4 1/2'

Gate at ●

● Gate at

● Curb Box