


LABOR AND MATERIALS

1	Copper } Connection	3/4	\$
1	Curb } Cock } Wolve } T.S. & V. }	3/4 in.	\$
1	Service box } Old returned }	{ Short 3-1/2 x 4-1/2 } { Long 4-1/2 x 5-1/2 }	\$
9	Ft. } 3/4 in. }	{ Copper } { } { }	Pipe at \$
	Nipples	in. at	\$
	Bushings	to in. at	\$
	Red'g		
	Inc'g		
	Union	in. at	\$
	Meter	in. at	\$
			\$
	Compound Joints at		\$
	Maintenance Foreman		\$
	Hrs. Water Maint. Man - 1 at		\$
	Hrs. Water Maint. Man - 2 at		\$
	Hrs. Garage Foreman	at	\$
	Hrs. Labor	at	\$
	Hrs. Compressor at		\$
			\$
	Trucking		\$
	Pav't Patch		\$
			\$
			\$
FLAUDREAUX Ave. No. 12

Name of Owner

Labor and Mat'l. Report 18 NOV. 29, 1933

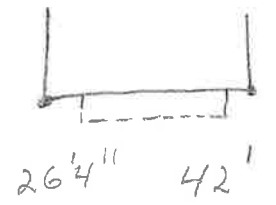

● Curb Box

4" Main Elev. of Main at tap 4'

Gate at ● Gate at

● Curb Box

OLD TAP SHUT OFF AT MAIN