

### LABOR AND MATERIALS


Copper	} Connection	_____	\$ _____	
Lead				
Curb	} Cock Valve T. S. & V. }	_____ in.	\$ _____	
		} Short 3 1/2 x 4 1/2 Long 4 1/2 x 5 1/2 Buff or Rdway }	_____	\$ _____
				\$ _____
Service box Old returned			\$ _____	
35 Ft. 3/4 in.	} Copper C.I. C.I. }	Pipe at _____	\$ _____	
Nipples _____ in.		at _____	\$ _____	
Bushings _____ to _____ in.		at _____	\$ _____	
Red'g Inc'g }	} Coupl'gs	_____ to _____ in.	\$ _____	
			\$ _____	
Union _____ in.	at _____	\$ _____		
Meter _____ in.	at _____	\$ _____		
Lead Joints at _____		\$ _____		
Compound Joints at _____		\$ _____		
Maintenance Foreman _____		\$ _____		
Hrs. Water Maint. Man—1 at _____		\$ _____		
Hrs. Water Maint. Man—2 at _____		\$ _____		
Hrs. Garage Foreman _____ at _____		\$ _____		
Hrs. Labor— _____ at _____		\$ _____		
Hrs. Compressor at _____		\$ _____		
Compensation Ins. at \$ _____ per C		\$ _____		
Trucking _____		\$ _____		
Pav't Patch _____		\$ _____		
_____		\$ _____		
_____		\$ _____		
_____		\$ _____		
O'head _____		\$ _____		
_____		\$ _____		

St.  
Pl.  
Ave. No. 1

~~Fort Amherst Court~~ COURT Ave. No. 1  
Name of Owner

LOUIS NOCK

Labor and Mat'l. Report Oct 23 1979

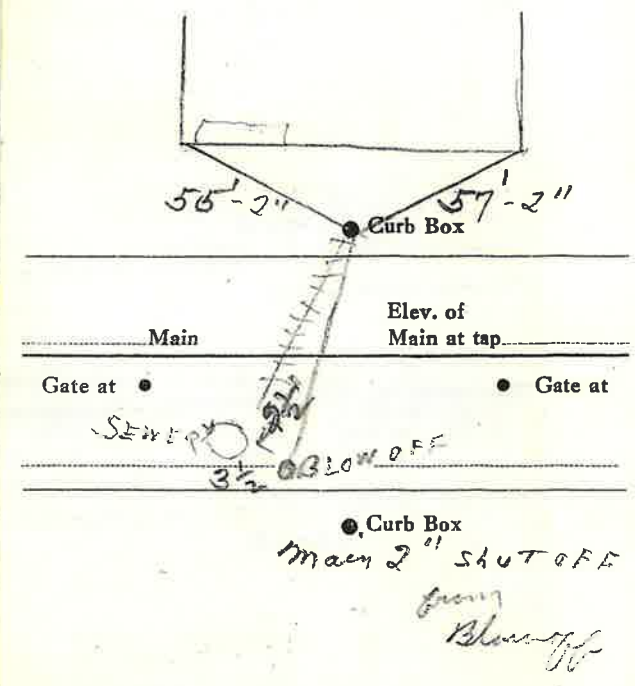


Fort Amherst  
court

GASS drip  
Box

old water line  
Right next to  
IT 3' deep

#1  
House

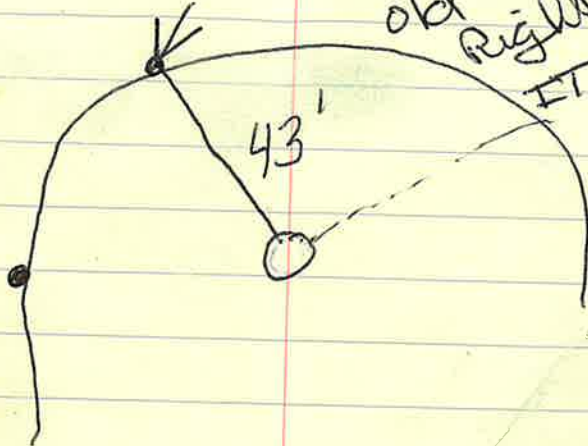

house