

LABOR AND MATERIALS

1	Copper Lead	Connection	1"	\$ 2.14
1	Curb	Cock Valve T-S. & V.	1" in.	\$ 2.61
1	Service Box	Short 3 1/2 x 4 1/2	} -----	\$ 1.60
	Old returned	Long 4 1/2 x 5 1/2		
		Buff. or Rdway		
10	Ft. 1" in.	Copper Galv Iron Cast Iron	Pipe at 22	\$ 2.20
	Nipples	in. at		\$ -----
	Bushings	to in. at		\$ -----
	Red'g Inc'g	Couplings	to in. at	\$ -----
	Union	in. at		\$ -----
	Meter	in. at		\$ -----
	Lead Joints	at		\$ -----
	Leadite Joints	at		\$ -----
	Hrs. Foreman	at		\$ -----
4	Hrs. Chauffeur	at	6 1/2	\$ 2.50
4	Hrs. Tapper	at	?	\$ 2.50
6	Hrs. Labor	at	45	\$ 2.70
	Hrs. Labor	at		\$ -----
	Hrs. Compressor	at		\$ -----
	Compensation Ins.			\$ 24
	Trucking			\$ 1. --
	Builders Use of Water	no patch (outside)		\$ -----
	Typh. House			\$ -----
				\$ -----
				\$ -----
				\$ 17.49

40 -- 1940

St.  
Pl.  
Ave. No.

Fort Amherst

Name of Owner

R J McMullen

Labor and Mat'l. Report

May 15 1940




● Curb Box

6" Main

Elev. of Main at tap 4 1/2

Gate at ●

● Gate at

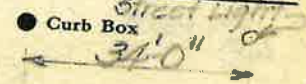

New tap

## LABOR AND MATERIALS

1 Copper	{ Connection	1" in.		\$ 2.14
1 Curb	{ Cock Valve T. S. & V.	1" in.		\$ 2.61
1 Service Box	{ Old returned	Short 3/2x4 1/2		\$ 1.60
		Long 4 1/2x5 1/2		
10 Ft. 1" in.	{ Copper Galv Iron Cast Iron	Pipe at 22		\$ 2.20
Nipples	in. at			\$
Bushings	to	in. at		\$
Red'g Inc'g	{ Couplings	to	in. at	\$
Union	in. at			\$
Meter	in. at			\$
Lead Joints	at			\$
Leadite Joints	at			\$
Hrs. Foreman	at			\$
4 Hrs. Chauffeur	at	6 1/2 hr		\$ 2.50
4 Hrs. Tapper	at			\$ 2.50
6 Hrs. Labor	at	4 1/2		\$ 2.70
Hrs. Labor	at			\$
Hrs. Compressor	at			\$
Compensation Ins.				\$ 24
Trucking				\$ 1.00
Builders Use of Water	no watch (outside)			\$
TAP & HPSSE				\$
				\$
				\$
				\$
				\$
<b>\$ 17.49</b>				

1 - - 1940

St.  
Pl.  
Ave. No.

Fort Ancherst


Name of Owner

R J McMullen

Labor and Mat'l. Report

May 16

1940

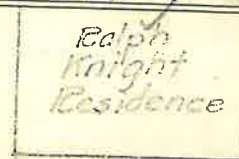

● Curb Box

6 Main

" 0.75"

" 0.75"

Elev. of Main at tap 4 1/2

Gate at ●

● Gate at

● Curb Box

New Tap

1 1/2"