

LABOR AND MATERIALS

Copper	}	Connection	\$
Lead			\$
Curb	}	T. S. & V.	in. \$
Valve			\$
Service Box			\$
Old returned	}	Short 3 1/2 x 4 1/2	\$
		Long 4 1/2 x 5 1/2	\$
		Buff. or Rdway	\$
Ft. <u>3/4</u> in.	}	Copper	Pipe at \$
		Galv. Iron	\$
		Cast Iron	\$
Nipples	in. at		\$
Bushings	to in. at		\$
Red'g	}	Couplings	to in. at \$
Inc'g			\$
Union	in. at		\$
Meter	in. at		\$
Lead Joints	at		\$
Leadite Joints	at		\$
Hrs. Foreman	at		\$
Hrs. Chauffeur	at		\$
Hrs. Tapper	at		\$
Hrs. Labor	at		\$
Hrs. Labor	at		\$
Hrs. Compressor	at		\$
Compensation Ins.			\$
Trucking			\$
Builders Use of Water			\$
			\$
			\$
			\$
			\$

St.

Pl.

Ft. Amherst

Ave. No. 14

Name of Owner


MacArthur

Geo. Knapp

Labor and Mat'l. Report

7-18-39

19

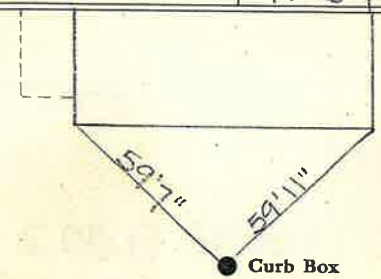

● Curb Box

6" Main

Elev. of Main at tap 5'

Gate at ●

● Gate at

● Curb Box


TAP MADE 11-12-28

LABOR AND MATERIALS

3/4 Copper } Connection _____ \$ _____
 Lead }
 Curb } Cock } _____ in. _____ \$ _____
 } Valve }
 } T.S. & V. }
 Service box { Short 3-1/2 x 4-1/2 } _____ \$ _____
 Old returned { Long 4-1/2 x 5-1/2 }
 Ft. _____ in. { Copper } Pipe at _____ \$ _____
 { G.I. }
 { C.I. }
 Nipples _____ in. at _____ \$ _____
 Bushings _____ to _____ in. at _____ \$ _____
 Red'g _____
 Inc'g _____
 Union _____ in. at _____ \$ _____
 Meter _____ in. at _____ \$ _____
 _____ \$ _____
 Compound Joints at _____ \$ _____
 Maintenance Foreman _____ \$ _____
 Hrs. Water Maint. Man - 1 at _____ \$ _____
 Hrs. Water Maint. Man - 2 at _____ \$ _____
 Hrs. Garage Foreman _____ at _____ \$ _____
 Hrs. Labor _____ at _____ \$ _____
 Hrs. Compressor at _____ \$ _____
 _____ \$ _____
 Trucking _____ \$ _____
 Pav't Patch _____ \$ _____
 _____ \$ _____
 _____ \$ _____
 _____ \$ _____
 _____ \$ _____

St. _____
 Ft. Amherst Pl. Ave. No. 14
 Name of Owner _____

Labor and Mat'l. Report 18 6/23/08

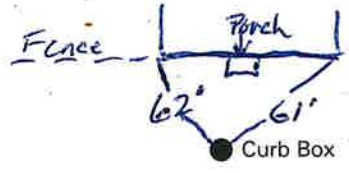

_____ Main Elev. of Main at tap _____

Gate at ● Gate at ●

6/23/08 ● Curb Box
 REPAIR CURB BOX

