

LABOR AND MATERIALS

1	Copper Lead	{ Connection	3/4"		\$ 3.04
1	Curb	{ Cock Valve F. S. & V. }	3/4 in.		\$ 3.54
1	Service box Old returned	{ Short 3 1/2 x 4 1/2 Long 4 1/2 x 5 1/2 Buff or Rdway }			\$ 4.70
28	Ft.	{ Copper G. I. C. I. }	3/4 in.	Pipe at	\$ 8.75
30	Nipples		in.	at	\$
	Bushings		to	in. at	\$
	Red'g Inc'g	{ Coupl'gs }	to	in. at	\$
	Union		in.	at	\$
	Meter		in.	at	\$
	Lead Joints at				\$
	Compound Joints at				\$
	Hrs. Water Maint. Man	— 1 at			\$
1	Hrs. Water Maint. Man	— 2 at			\$ 1.13
1	Hrs. Labor	— at			\$ 1.02
	Hrs. Labor	— at			\$
	Hrs. Compressor at				\$
	Compensation Ins. at \$	per C.			\$.06
	Trucking				\$ 1.00
	Pav't Patch	Outside City			\$
					\$
					\$
					\$
					\$
	O'head				\$


Tap by Moquin
3/15/51
\$23.24
135

37-1951

Ft. Antler St Rd. Ave. No. 18

Name of Owner
Jones

Labor and Mat'l. Report 3 - 15 - 1951

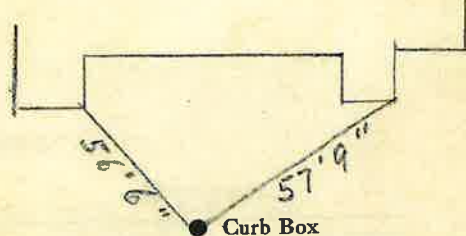

6" Main Elev. of Main at tap 5'

Gate at ● ● Gate at

● Curb Box