


# LABOR AND MATERIALS

1	Copper } Connection	3/4"	\$
	Lead } Connection		
1	Curb } Cock	3/4" in.	\$
	Valve } 10-2-1/2		
1	Service box } Short 3-1/2 x 4-1/2		\$
	Old returned } Long 4-1/2 x 5-1/2		
25	Ft. 3/4 in. } Copper		\$
		Gal. Gal.	
		Pipe at	\$
	Nipples	in. at	\$
	Bushings	to in. at	\$
	Red'g		
	Inc'g		
	Union	in. at	\$
	Meter	in. at	\$
			\$
	Compound Joints at		\$
	Maintenance Foreman		\$
	Hrs. Water Maint. Man - 1 at		\$
	Hrs. Water Maint. Man - 2 at		\$
	Hrs. Garage Foreman	at	\$
	Hrs. Labor	at	\$
	Hrs. Compressor at		\$
			\$
	Trucking		\$
	Pav't Patch		\$
			\$
			\$
RD. FT. AMHERST  
 St. No. 20  
 Ave. No. 20  
 Name of Owner

Labor and Mat'l. Report 1936, SEPT. 28

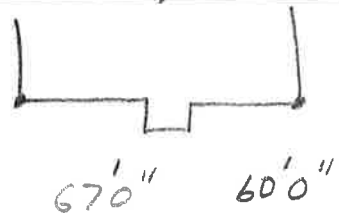

● Curb Box

6" Main Elev. of Main at tap 5'

Gate at ● Gate at ●

● Curb Box

NEW HOUSE