


# LABOR AND MATERIALS

_____	Copper	} Connection	_____	\$ _____
_____	Lead			
_____	Curb	} Cock Valve T.S. & V. }	_____ in.	\$ _____
_____	Service box		{ Short 3-1/2 x 4-1/2 } _____	\$ _____
_____	Old returned			{ Long 4-1/2 x 5-1/2 } _____
_____	Ft. _____ in.	} Copper } Pipe at _____	\$ _____	
_____	Nipples _____ in. at _____		{ G.I. }	\$ _____
_____	Bushings _____ to _____ in. at _____		{ C.I. }	\$ _____
_____	Red'g			\$ _____
_____	Inc'g			\$ _____
_____	Union _____ in. at _____		\$ _____	
_____	Meter _____ in. at _____		\$ _____	
_____			\$ _____	
_____	Compound Joints at _____		\$ _____	
_____	Maintenance Foreman _____		\$ _____	
_____	Hrs. Water Maint. Man - 1 at _____		\$ _____	
_____	Hrs. Water Maint. Man - 2 at _____		\$ _____	
_____	Hrs. Garage Foreman _____ at _____		\$ _____	
_____	Hrs. Labor _____ at _____		\$ _____	
_____	Hrs. Compressor at _____		\$ _____	
_____			\$ _____	
_____	Trucking _____		\$ _____	
_____	Pav't Patch _____		\$ _____	
_____			\$ _____	
_____			\$ _____	
St. \_\_\_\_\_  
Pl. \_\_\_\_\_  
Ave. No. \_\_\_\_\_

Name of Owner  
21 FT AMBERST

Labor and Mat'l. Report 19

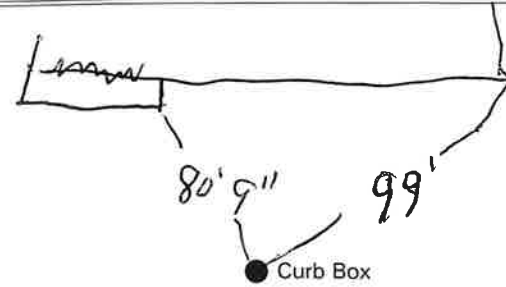

20' Main  
Elev. of Main at tap \_\_\_\_\_

Gate at ● Gate at ●

● Curb Box