

LABOR AND MATERIALS


1	Copper Lead	} Connection	3/4"	\$		
1	Curb			} Cock Valve F.S. & V.	3/4 in.	\$
1	Service box	} Short 3 1/2 x 4 1/2	}			\$
	Old returned			Long 4 1/2 x 5 1/2	Buff or Rdway	
27	Ft. 3/4 in.	} Copper	}	\$		
					C.I.	Pipe at
	Nipples	in.	at	\$		
	Bushings	to	in.	at	\$	
	Red'g	} Coupl'gs	to	in.	at	\$
	Inc'g					
	Union	in.	at	\$		
	Meter	in.	at	\$		
	Lead Joints	at	\$			
	Compound Joints	at	\$			
	Maintenance Foreman	at	\$			
	Hrs. Water Maint. Man-1	at	\$			
	Hrs. Water Maint. Man-2	at	\$			
	Hrs. Garage Foreman	at	\$			
	Hrs. Labor	at	\$			
	Hrs. Compressor	at	\$			
	Compensation Ins.	at \$	per C	\$		
	Trucking	\$				
	Pav't Patch	\$				
	Tap by Gifford & Co	\$				
	10-21-60.	\$				
	O'head	\$				
		\$				

N.G.F.

St. Rd.
 Ft. Amherst Pl.
 Ave. No. 24

Name of Owner
 Albert Hillman.

Labor and Mat'l. Report Oct. 21 1960

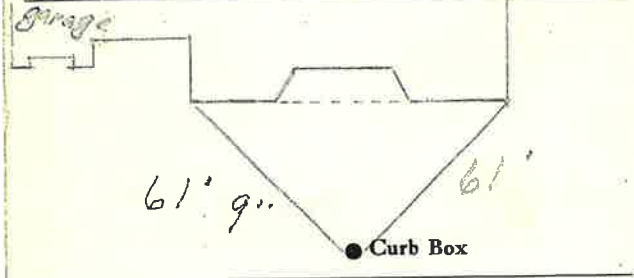

6" Main Elev. of Main at tap 4 1/2'

Gate at • Gate at

• Curb Box