

LABOR AND MATERIALS


1	Copper	} Connection	3/4"	\$ 125
1	Lead			
1	Curb	} Cock Valve T. S. & V.	3/4 in.	\$ 170
1	Service box Old returned			
		{ Short 3 1/2 x 4 1/2 Long 4 1/2 x 5 1/2 Buff or Rdway }		\$ 145
25	3/4 in.	{ Copper G. I. G. I. }	Pipe at	\$ 338
	Nipples	in. at		\$
	Bushings	to in. at		\$
	Red'g } Inc'g }	Coupl'gs	to in. at	\$
	Union	in. at		\$
	Meter	in. at		\$
	Lead Joints	at		\$
	Compound Joints	at		\$
3	Maintenance Foreman	6 2/2		\$ 188
	Hrs. Water Maint. Man-1	at		\$
	Hrs. Water Maint. Man-2	at		\$
	Hrs. Garage Foreman	at		\$
7	Hrs. Labor	at 50		\$ 150
	Hrs. Compressor	at		\$
	Compensation Ins. at \$	per C		\$ 11
	Trucking			\$ 105
	Pav't Patch			\$
	O'head			\$
				\$ 1177

N.G.F.

Fort Annapolis St. ~~Blvd~~ Ave. No. 26

Name of Owner
Fred Peluca

Labor and Mat'l. Report May 2 1935

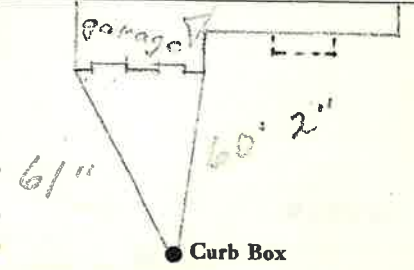

6" Main Elev. of Main at tap 4'

Gate at • Gate at

• Curb Box