

LABOR AND MATERIALS


1 Copper } Connection  $\frac{3}{4}$ " in. \$  
 Lead }  
 1 Curb } Cock }  $\frac{3}{4}$ " in. or seal \$  
 Valve }  
 T. S. & V. }  
 1 Service box { Short  $3\frac{1}{2}$  x  $4\frac{1}{2}$  }  
 Old returned { Long  $4\frac{1}{2}$  x  $5\frac{1}{2}$  }  
 Buff or Rdway } \$  
 28 Ft.  $\frac{3}{4}$ " in. { Copper } Pipe at \$  
 { G. I. }  
 { C. I. }  
 Nipples in. at \$  
 Bushings to in. at \$  
 Red'g }  
 Inc'g } Coupl'gs to in. at \$  
 Union in. at \$  
 Meter in. at \$  
 Lead Joints at \$  
 Compound Joints at \$  
 Maintenance Foreman \$  
 Hrs. Water Maint. Man-1 at \$  
 Hrs. Water Maint. Man-2 at \$  
 Hrs. Garage Foreman at \$  
 Hrs. Labor at \$  
 Hrs. Compressor at \$  
 Compensation Ins. at \$ per C. \$  
 Trucking \$  
 Pav't Patch \$  
 Tap by Gissord \$  
 J. Peterson \$  
 5-9-63. \$  
 O'head \$  
 \$

N.G.F. Rd.

Ft. Amberst St. Pl. Ave. No. 28

Name of Owner  
 Constantine Backus

Labor and Mat'l. Report May 9 1963

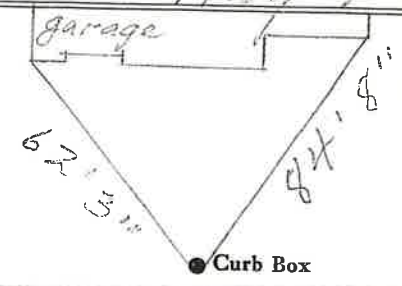

6" C.I. Main Elev. of Main at tap 5'

Gate at • Gate at •

• Curb Box