


LABOR AND MATERIALS

- 3/4 Copper } Connection _____ \$ _____
- 1 Curb } ~~Iron~~ Cock Valve } 3/4 in. _____ \$ _____
- 1 Service box { ~~Old returned~~ Short 2-1/2 x 4-1/2 } _____ \$ _____
- 27 Ft. 3/4 in. { ~~Cast~~ Copper } Pipe at _____ \$ _____
- _____ Nipples _____ in. at _____ \$ _____
- _____ Bushings _____ to _____ in. at _____ \$ _____
- _____ Red'g _____
- _____ Inc'g _____
- _____ Union _____ in. at _____ \$ _____
- _____ Meter _____ in. at _____ \$ _____
- _____ _____ \$ _____
- _____ Compound Joints at _____ \$ _____
- _____ Maintenance Foreman _____ \$ _____
- _____ Hrs. Water Maint. Man - 1 at _____ \$ _____
- _____ Hrs. Water Maint. Man - 2 at _____ \$ _____
- _____ Hrs. Garage Foreman _____ at _____ \$ _____
- _____ Hrs. Labor _____ at _____ \$ _____
- _____ Hrs. Compressor at _____ \$ _____
- _____ _____ \$ _____
- _____ Trucking _____ \$ _____
- _____ Pav't Patch _____ \$ _____
- _____ _____ \$ _____
- _____ _____ \$ _____
Rd. _____
 St. _____
 Ft. _____
 Ave. No. 30

FT. AMHERST
 Name of Owner
T.M. AVERY

Labor and Mat'l. Report 19 29, SEPT. 4

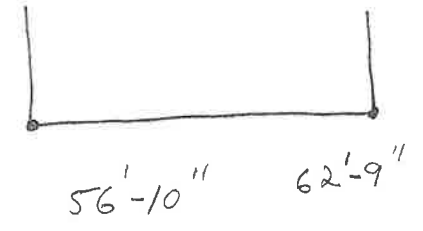

● Curb Box

6" Main Elev. of Main at tap 5'

Gate at ● ● Gate at

● Curb Box

DAVISON + GRIFFIN LEO
 BY HOVEY