

LABOR AND MATERIALS

1	Copper Lead	Connection	3/4"	\$	2.41
1	Curb	Cock Valve T.S. & V.	in.	\$	3.41
1	Service box Old returned	Short 3 1/2 x 4 1/2 Long 4 1/2 x 5 1/2 Buff. or Rdway		\$	4.18
10	Ft. 3/4 in.	Copper <del>C.I.</del> C.I.	Pipe at 40	\$	4.00
	Nipples	in. at		\$	
	Bushings	to in. at		\$	
	Red'g Inc'g	Coupl'gs	to in. at	\$	
	Union	in. at		\$	
	Meter	in. at		\$	
	Lead Joints at			\$	
	Compound Joints at			\$	
	Maintenance Foreman			\$	14.00
	Hrs. Water Maint. Man-1 at			\$	
4	Hrs. Water Maint. Man-2 at	124		\$	4.96
	Hrs. Garage Foreman at			\$	
8	Hrs. Labor— at	113		\$	9.04
	Hrs. Compressor at			\$	
	Compensation Ins. at \$3.861 per C.			\$	54
	Trucking			\$	1.50
	Pay't Patch			\$	6.75
	Tap by Giggord			\$	
	9-9-54			\$	
	O'head			\$	
				\$	36.79


30.04

102-54

St: \_\_\_\_\_  
Pl: \_\_\_\_\_  
Ave. No. 31

Name of Owner  
Cogan

Labor and Mat'l. Report Sept. 9 1954

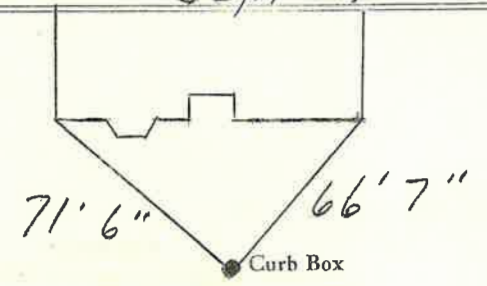

6" Main Elev. of Main at tap 5'

Gate at • Gate at

TAX ID # 302.11-3-8

• Curb Box