


LABOR AND MATERIALS

1	Copper } Connection	<u>3/4</u>	\$	_____
1	Curb } Cock Valve	<u>3/4</u> in.	\$	_____
1	Service box } Old returned { Short 3-1/2 x 4-1/2		\$	_____
		Long 4-1/2 x 5-1/2		_____
<u>26</u>	Ft. <u>3/4</u> in. { Copper } Pipe at		\$	_____
_____	Nipples _____ in. at		\$	_____
_____	Bushings _____ to _____ in. at		\$	_____
_____	Red'g		\$	_____
_____	Inc'g		\$	_____
_____	Union _____ in. at		\$	_____
_____	Meter _____ in. at		\$	_____
_____			\$	_____
_____	Compound Joints at		\$	_____
_____	Maintenance Foreman		\$	_____
_____	Hrs. Water Maint. Man - 1 at		\$	_____
_____	Hrs. Water Maint. Man - 2 at		\$	_____
_____	Hrs. Garage Foreman _____ at		\$	_____
_____	Hrs. Labor _____ at		\$	_____
_____	Hrs. Compressor at		\$	_____
_____			\$	_____
_____	Trucking		\$	_____
_____	Pav't Patch		\$	_____
_____			\$	_____
_____			\$	_____
R.O.
 FORT AMHERST No. 34

Name of Owner
COWAN

Labor and Mat'l. Report 1936, JAN. 24

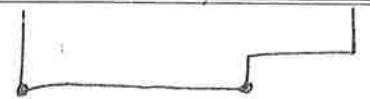

62'10" 61'5"

● Curb Box

6" Main Elev. of Main at tap 4 1/2'

Gate at ● ● Gate at

● Curb Box

NEW HOUSE