

LABOR AND MATERIALS

1	Copper	Connection	3/4"	\$	2.76
1	Lead			\$	
1	Curb	Cock Valve	3/4 in.	\$	3.49
		T. S. & V.		\$	
1	Service box	Short 3 1/2 X 4 1/2		\$	4.74
	Old returned	Long 4 1/2 X 5 1/2		\$	
		Buff or Rdway		\$	
2.7	Ft.	3/4 in.	Copper Pipe at	35	\$ 9.45
			G.I.		
			C.I.		
	Nipples	in. at		\$	
	Bushings	to in. at		\$	
	Red'g			\$	
	Inc'g	Coupl'gs to in. at		\$	
	Union	in. at		\$	
	Meter	in. at		\$	
	Lead Joints	at		\$	
	Compound Joints	at		\$	
	Hrs. Water Maint. Man-1	at		\$	
2	Hrs. Water Maint. Man-2	at	1.24	\$	2.48
4	Hrs. Labor-	at	1.13	\$	4.52
	Hrs. Labor-	at		\$	
	Hrs. Compressor	at		\$	
	Compensation Ins.	at \$ 3.106 per C		\$	26
	Trucking			\$	1.00
	Pav't Patch			\$	
	Tap by Gifford	9-30-52		\$	
	O'head			\$	
				\$	29.70
				\$	80
				\$	2890

2890


N. G. F.

St. Fort Amberst Ave. No. 40

Name of Owner

Cortright

Labor and Mat'l. Report Sept. 30 1952

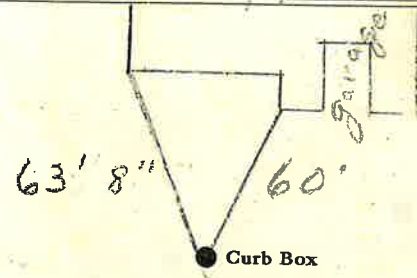

6" Main Elev. of Main at tap 5'

Gate at ● Gate at ●

● Curb Box